
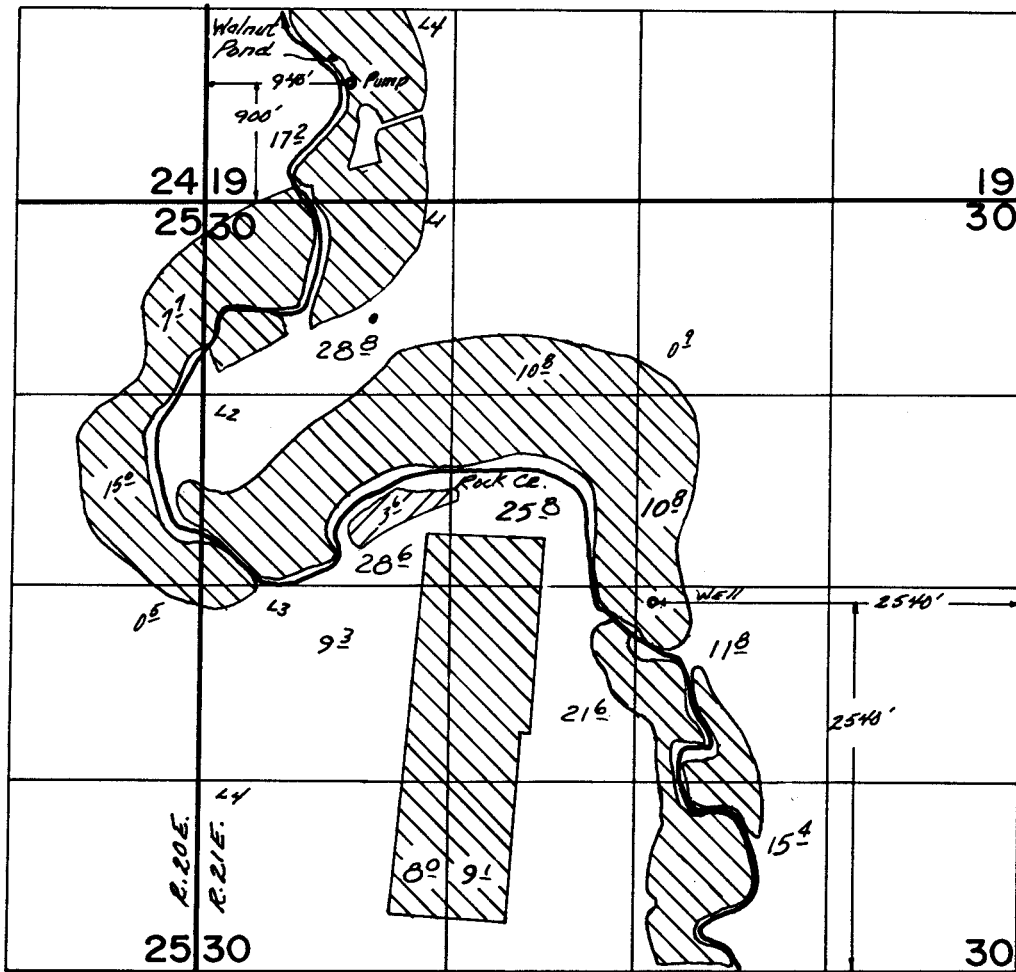
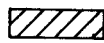


G-7342
75577

T.1N,R.20&21E,W.M.

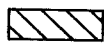

 - Primary
 - Suppl.

FINAL PROOF SURVEY

UNDER

Application No. G-7279 Permit No. G-7342...
IN NAME OF

JAMES & JOHN HABBERSTAD

Surveyed June 13, 1979, by S.C. BROWN.....