


T.18S. R.12E. W.M.

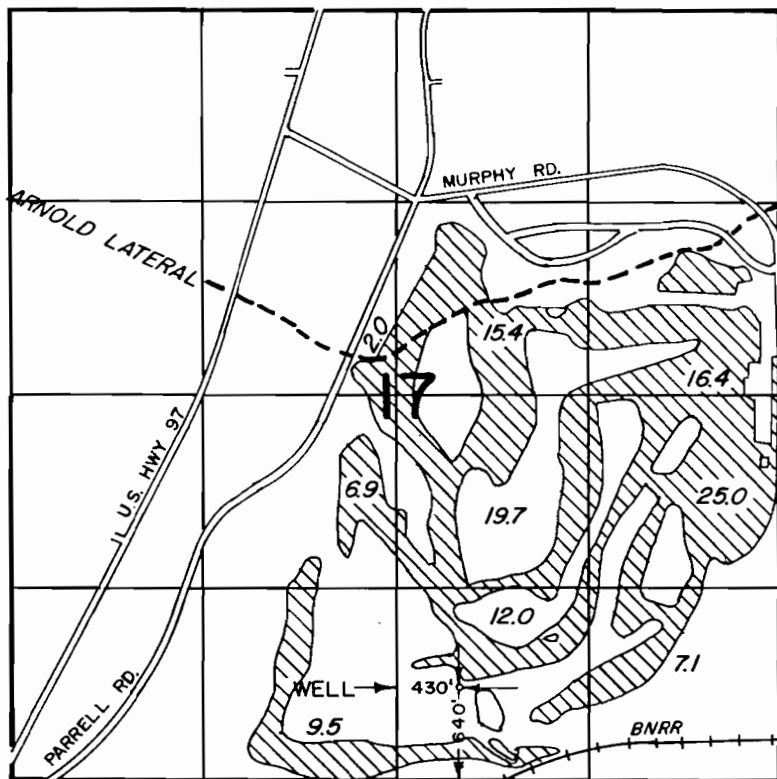

FINAL PROOF SURVEY

UNDER

TRANSFER 3878

Application No. G-9077. Permit No. G-8541.....

IN NAME OF

BEND GOLF CLUB, INC.

Surveyed JUN. 9 1982, by L.H. NUNN.....

AUG. 17, 1982