


T. 14 S., R. 5 W., W. M.

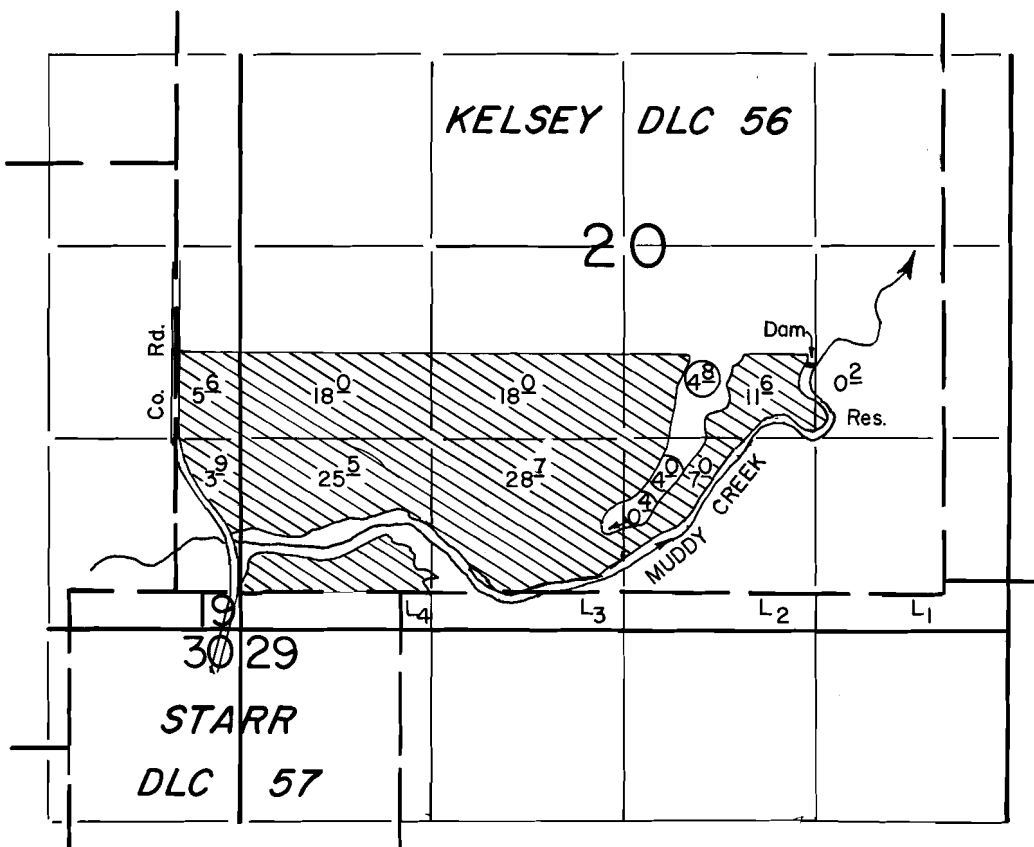

P.O.D. Loc.: 1560' N. & 900' W. from SE Cor. DLC 56.

Scale : 1" = 1320'

FINAL PROOF SURVEY
UNDER

R-55305 R-7807
Application No.55306 Permit No. 43995.....
IN NAME OF

JOHN F. BOYER

Surveyed JULY 12 1983, by L.M. TOLL.....
SEPT. 23 1987, T. M. WARREN