


T-4883

T.11S. R.4 W. W.M.

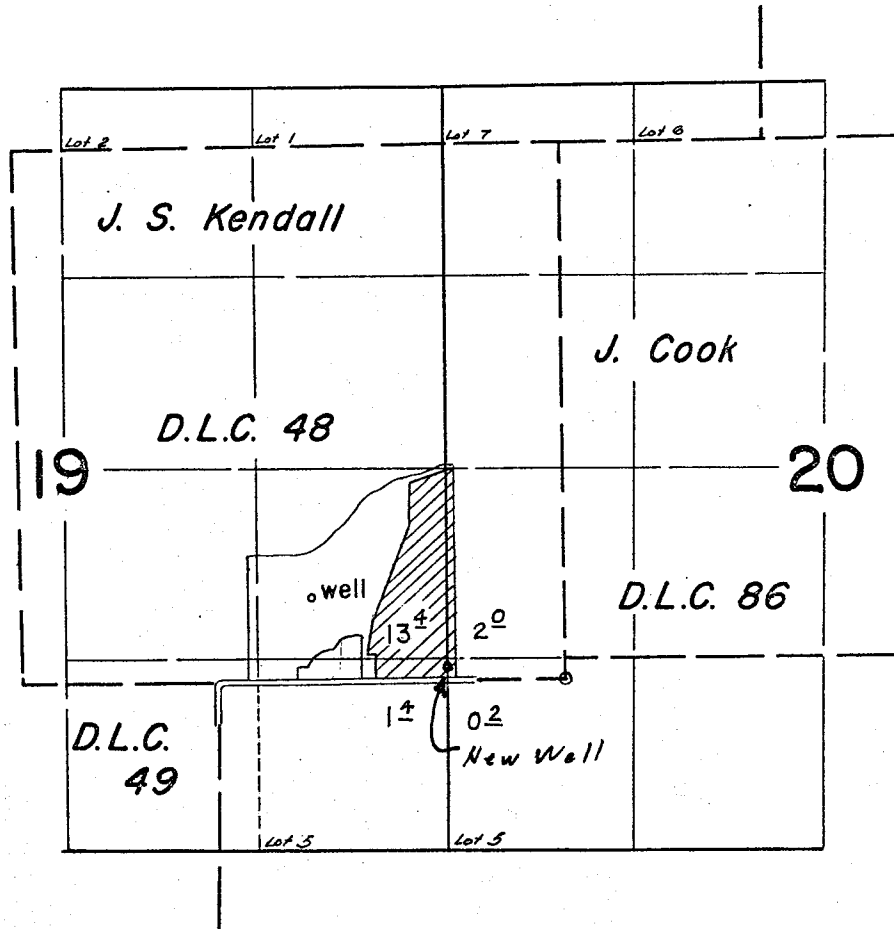

FINAL PROOF SURVEY UNDER

Application No. G-1603 Permit No. G-1475
IN NAME OF

C. R. CRIST

Surveyed April 22 1963, by C.R. Baker...
Mar. 1 1965 F. Siegmund