


T. 6 S. R. 1 W. W. M.

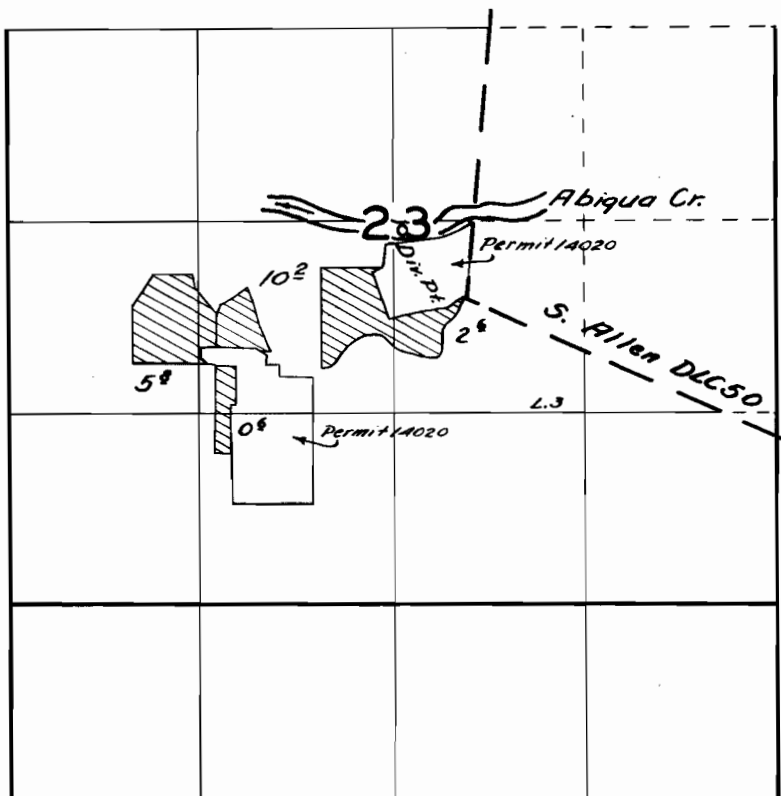

FINAL PROOF SURVEY

UNDER

Application No. 27152 Permit No. 21354

IN NAME OF

Elser Aarhus

Surveyed May 22 1956, by G.O. Bartels