


T.21 & 22S.R.5W.W.M.

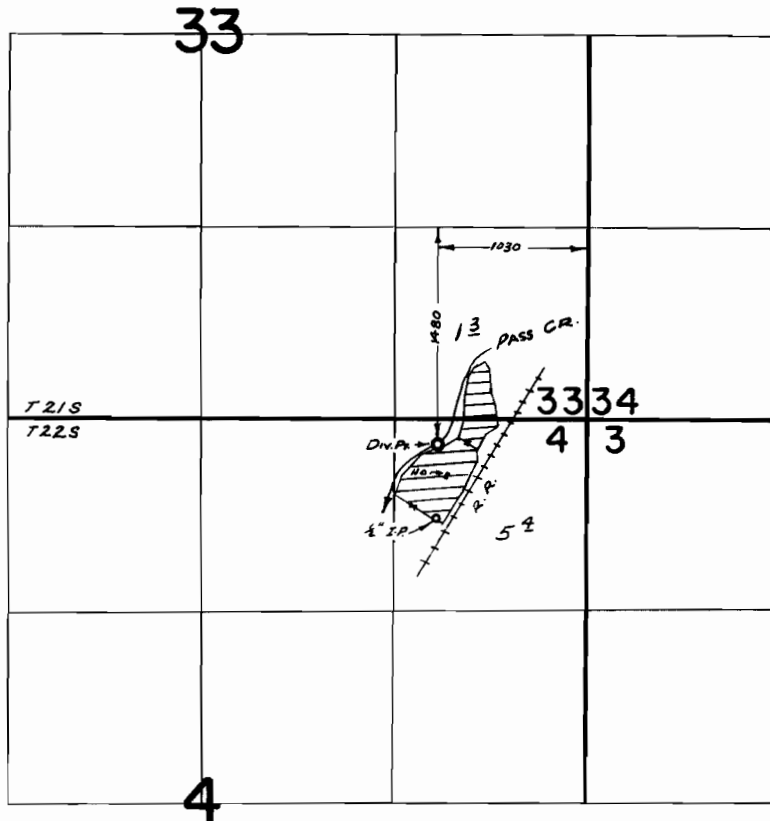

FINAL PROOF SURVEY UNDER

Application No. 41948 Permit No. 31189
IN NAME OF

WILLIAM C. & NONDYS V. WOOLEY

Surveyed JUNE 8, 1970, by R. MUCKEN...