

UNITED STATES
DEPARTMENT OF THE INTERIOR
BUREAU OF LAND MANAGEMENT

R2810
75382
75610


SECTION

28

Oregon State Water Filings

TOWNSHIP 37S, RANGE 23E, W. M.

North

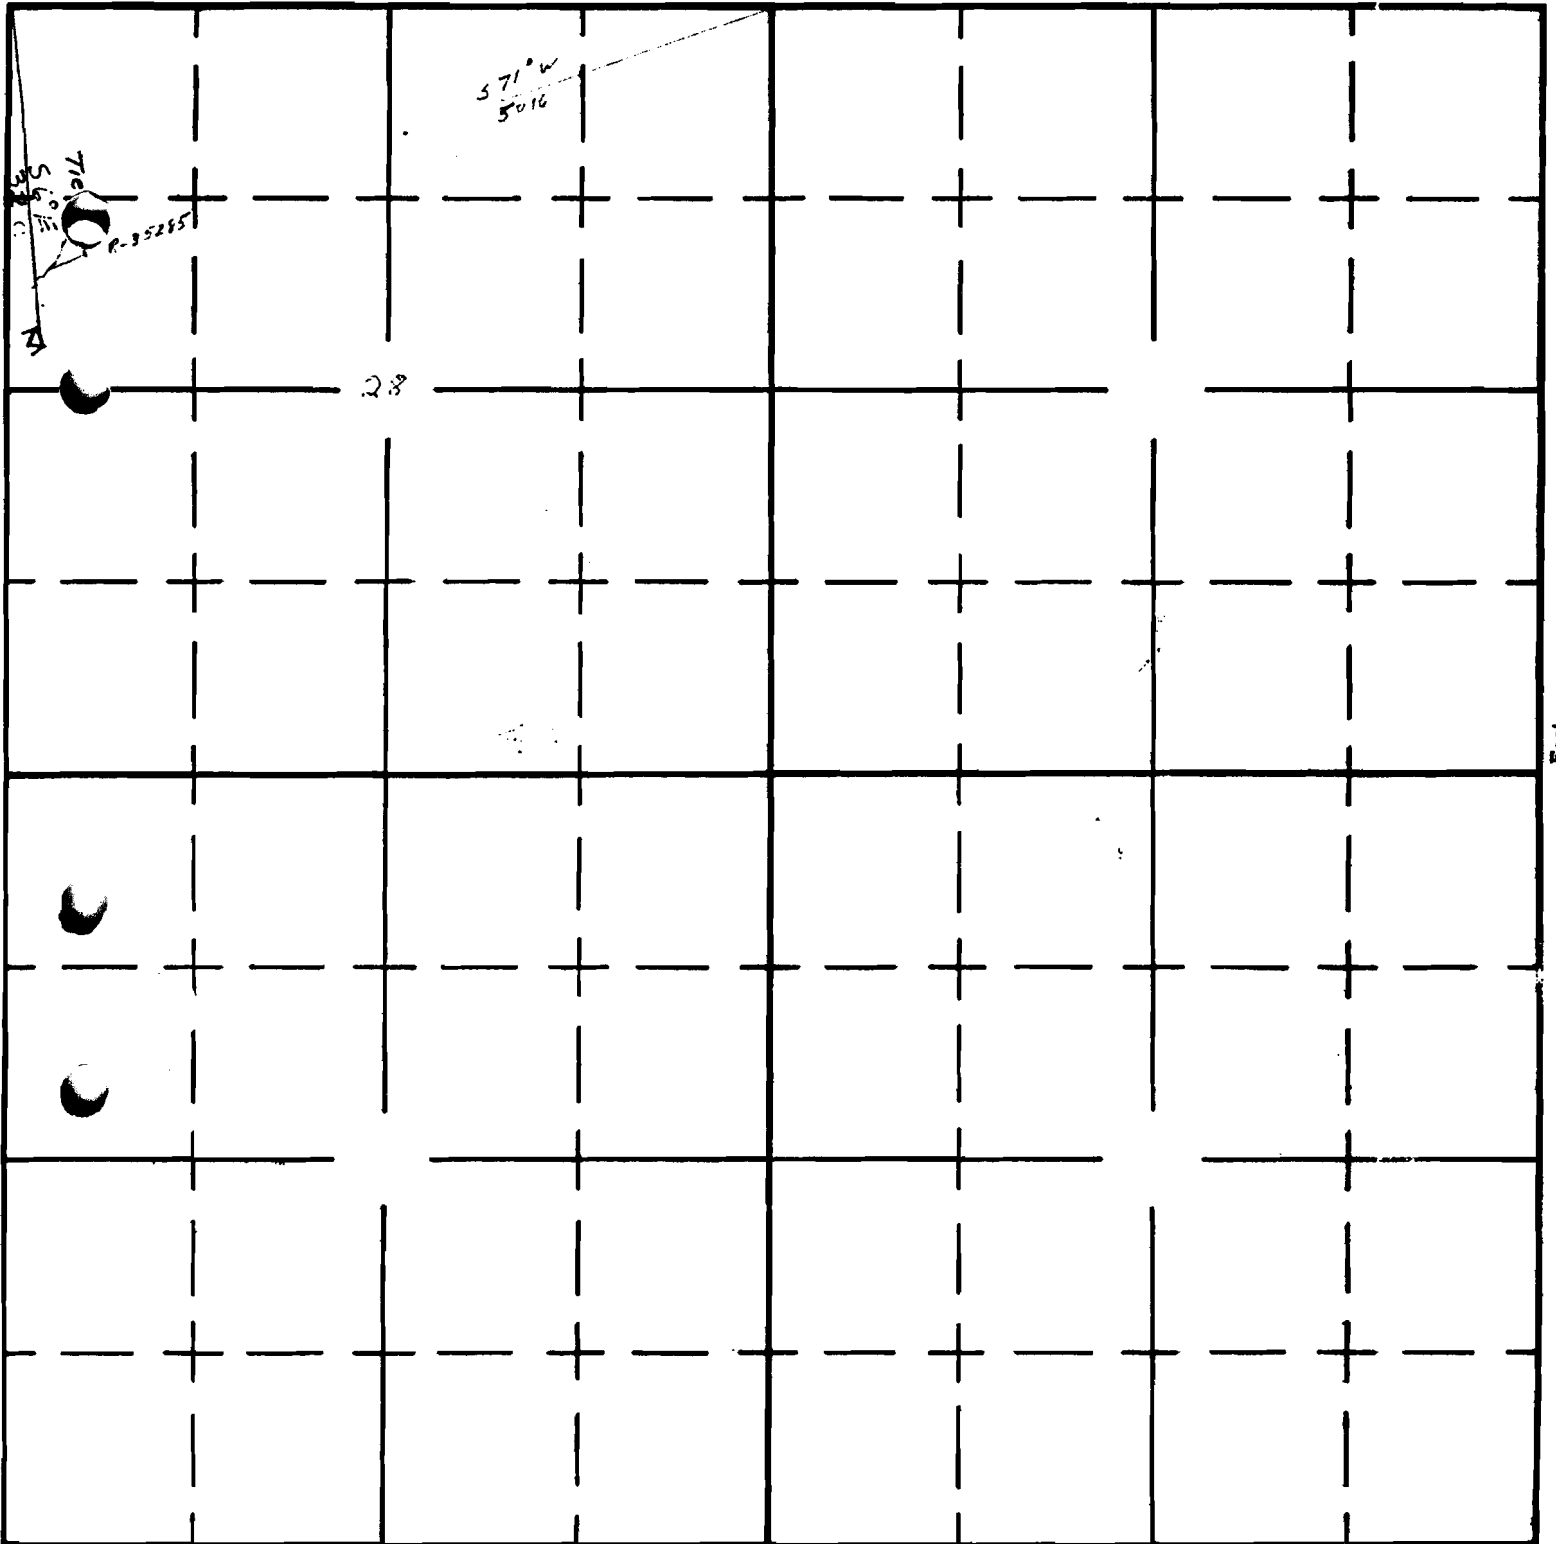

No CORNER Found

South

Tied in with Aerial Photos and Oregon State Highway Maps

APPLICATION No. R-34711
PERMIT No. R-2810