

Form OR-010-7300-2
4/83

UNITED STATES
DEPARTMENT OF THE INTERIOR
BUREAU OF LAND MANAGEMENT

R9519
75402
75612

Section

22

SE SW


Township 28 south
Range 16 east

Appl. No. R67663

Permit No. R 9519

Indian Skull Reservoir #2

3590

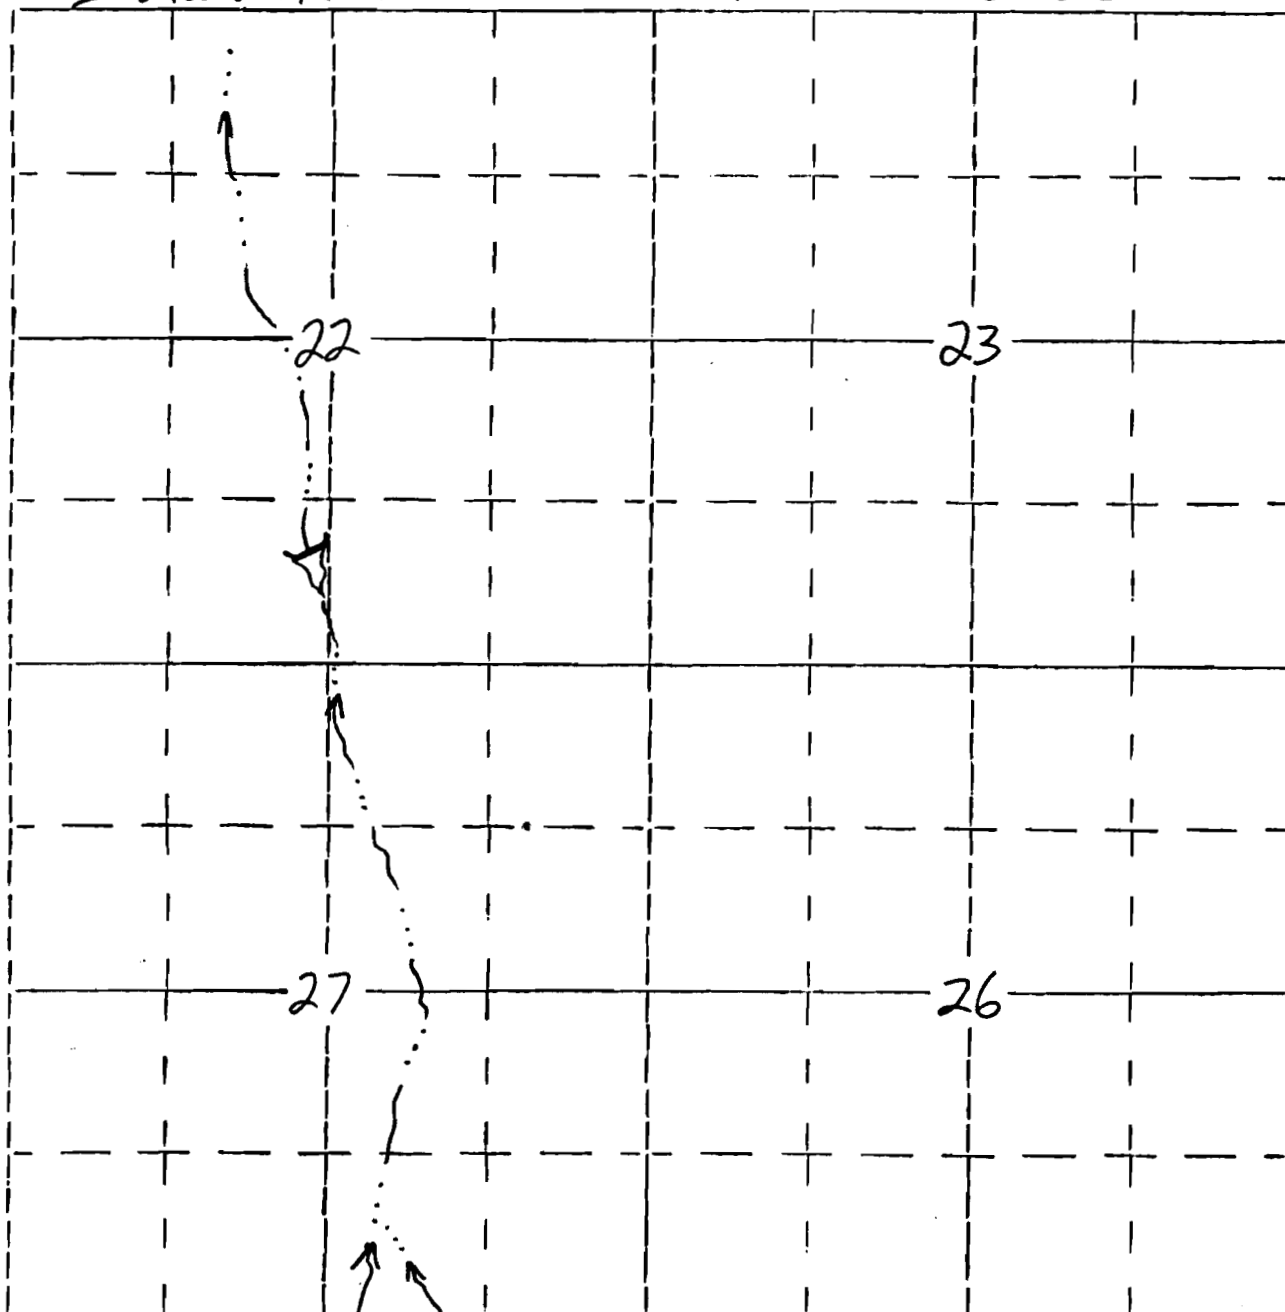

895' N., 2480' E. of SW corner, section 22