


T. 34S., R. 31 & 32E., W.M.

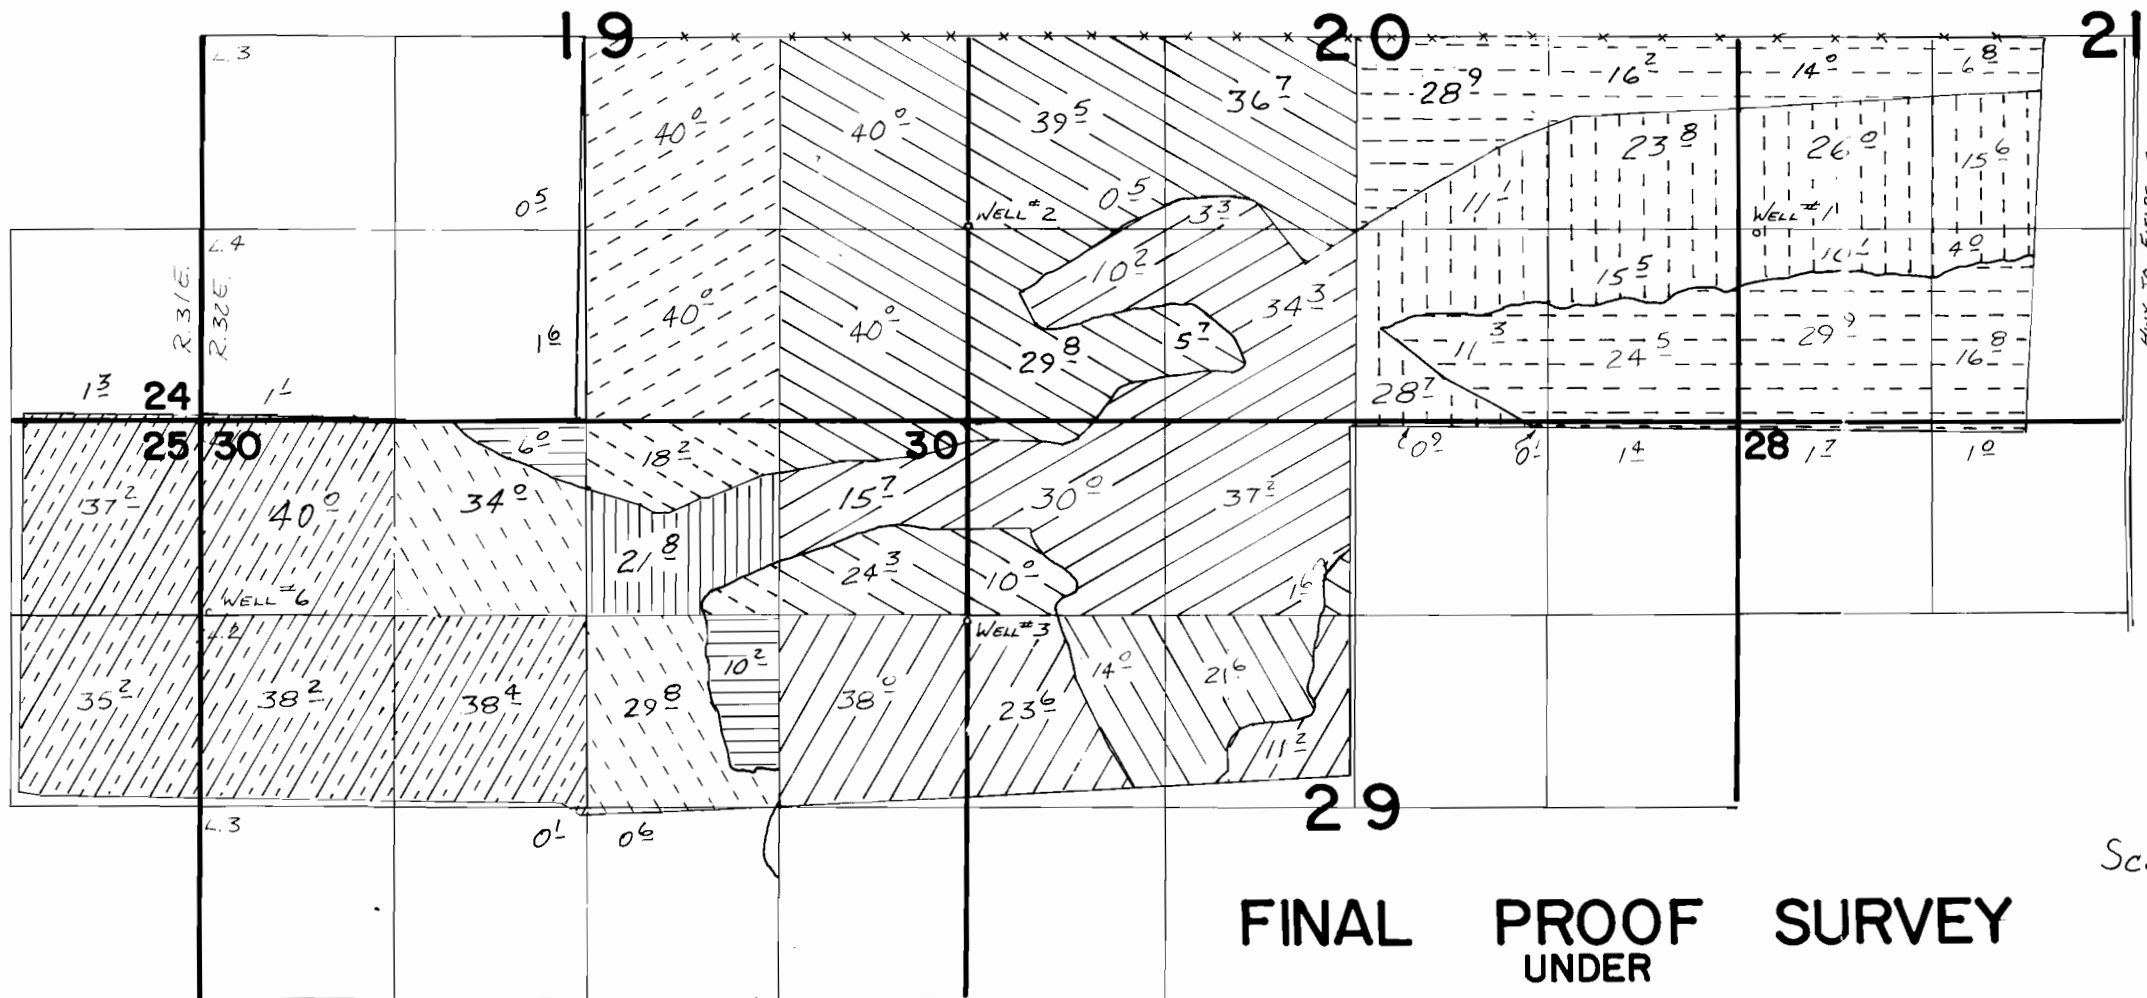

Scale 1" = 1320'

FINAL PROOF SURVEY
UNDER

APPL. G-3331
G-3936
G-5072
G-3848

PER. G-3169
G-3691
G-4789
G-3624

IN NAME OF

INA LIFE INS. CO.

Survey 7-21, 1988, by VERN L. CHURCH

- | | | | |
|---|--------------------------------|---|--|
|  | PER. G-3169
PRIMARY WELL #2 |  | PER. G-3624
WELL #1 Loc: 1300'N. & 120'E. FROM SW COR.
SEC. 21 |
|  | PER. G-3169
SUPPL. WELL #2 |  | PER. G-3691
WELL #2 Loc: 1340'N. FROM SW COR. SEC. 20.
PRIMARY WELL #2 |
|  | PER. G-3169
PRIMARY WELL #3 |  | PER. G-3691
WELL #3 Loc: 1380'S. FROM NW COR. SEC. 29
SUPPL. WELL #2 |
|  | PER. G-3169
SUPPL. WELL #3 |  | PER. G-4789
WELL #6 Loc: 1310'S. & 50'E. FROM NW COR.
PRIMARY WELL #3
SEC. 30. ALL IN T. 34 S. R. 32 E. |
|  | PER. G-3169
PRIMARY WELL #1 |  | PER. G-4789
SUPPL. WELL #3 |
|  | PER. G-3169
SUPPL. WELL #1 |  | PER. G-4789
SUPPL. WELL #6 |