


T. 34S., R. 31 & 32E., W.M.

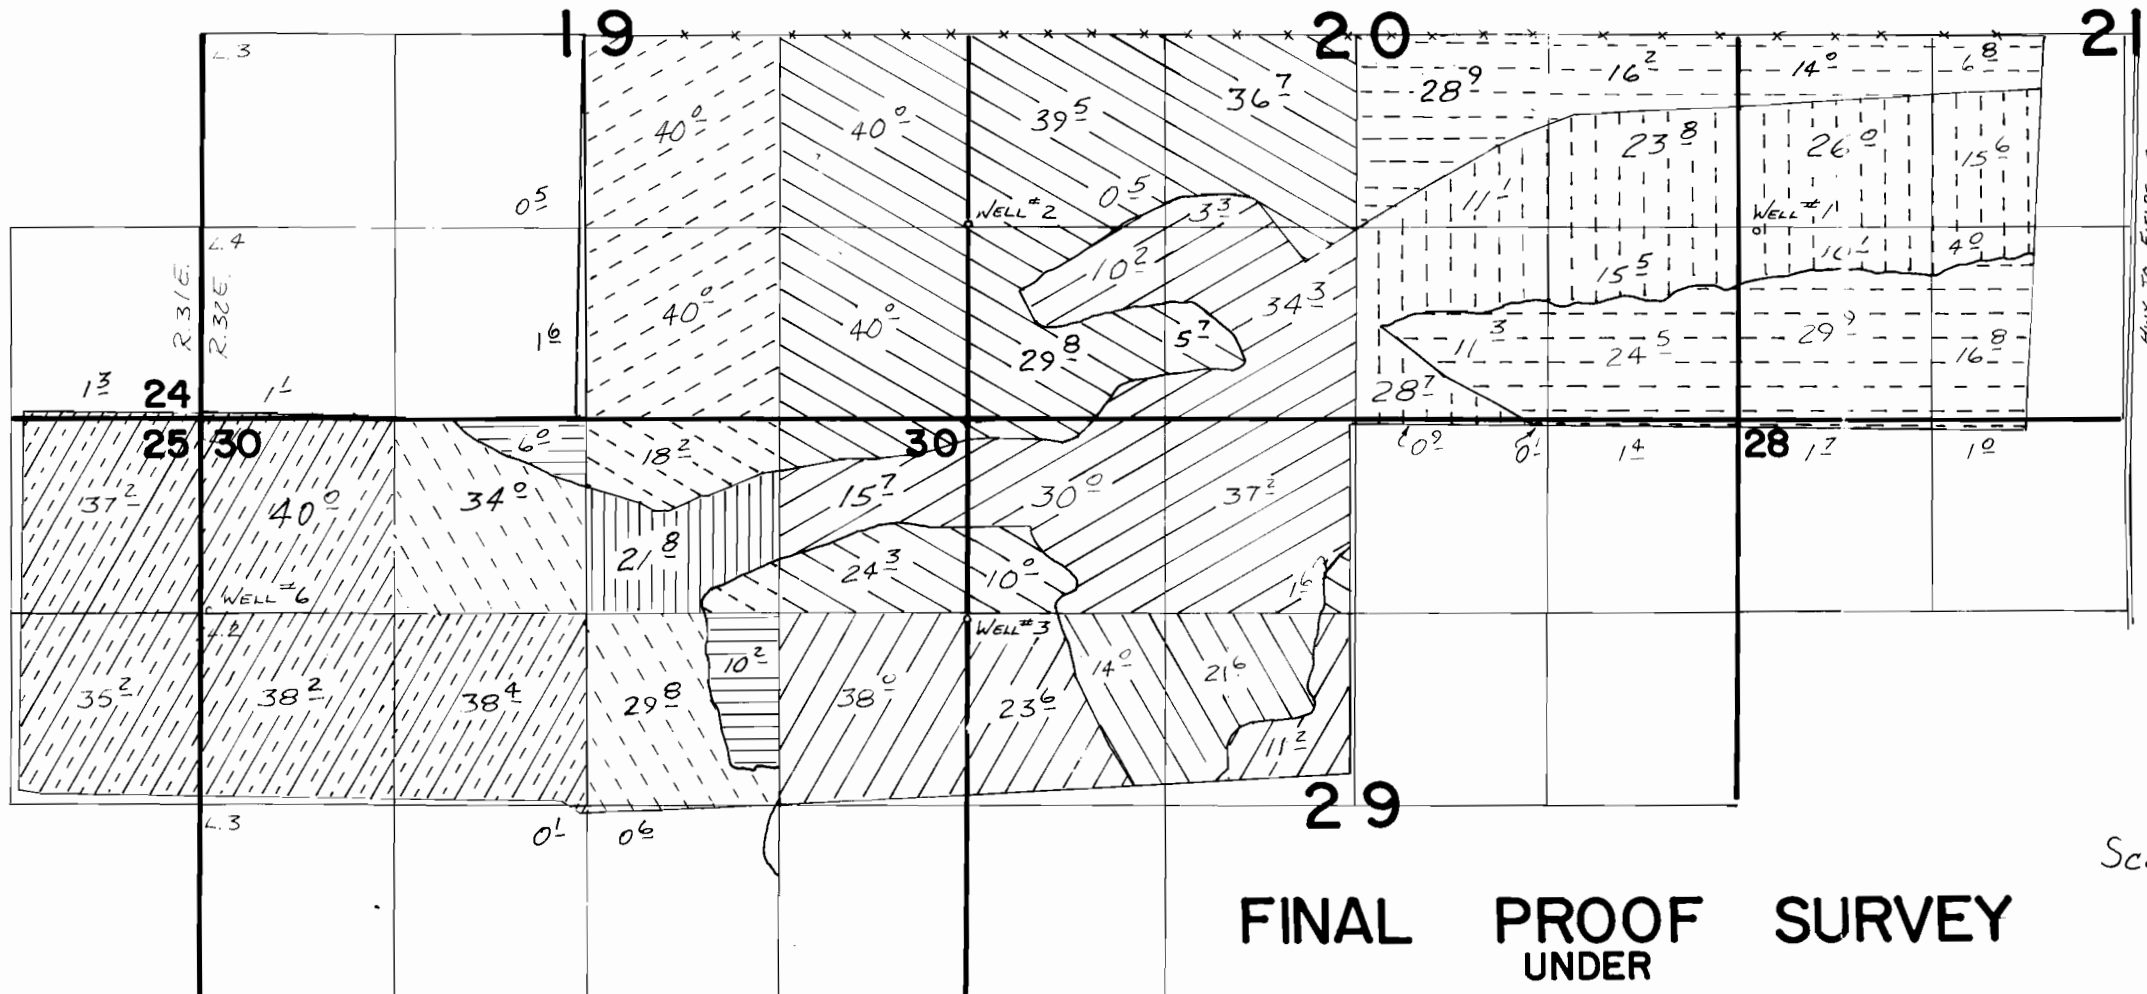

Scale 1" = 1320'

FINAL PROOF SURVEY UNDER

APPL. G-3331
G-3936
G-5072
G-3848

PER. G-3169
G-3691
G-4789
G-3624

IN NAME OF

INA LIFE INS. CO.

Survey 7-21, 1988, by VERN L. CHURCH

- PER. G-3169
PRIMARY WELL #2
- PER. G-3169
SUPPL. WELL #2
- PER. G-3169
PRIMARY WELL #3
- PER. G-3169
SUPPL. WELL #3
- PER. G-3169
PRIMARY WELL #1
- PER. G-3169
SUPPL. WELL #1

- PER. G-3624
- PER. G-3691
PRIMARY WELL #2
- PER. G-3691
SUPPL. WELL #2
- PER. G-4789
PRIMARY WELL #3
- PER. G-4789
SUPPL. WELL #3
- PER. G-4789
SUPPL. WELL #6

WELL #1 Loc: 1300' N. & 120' E. FROM SW COR.
SEC. 21
WELL #2 Loc: 1340' N. FROM SW COR. SEC. 20.
WELL #3 Loc: 1380' S. FROM NW COR. SEC. 29
WELL #6 Loc: 1310' S. & 50' E. FROM NW COR.
SEC. 30. ALL IN T. 34S. R. 32E.