
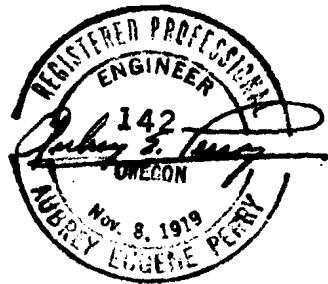
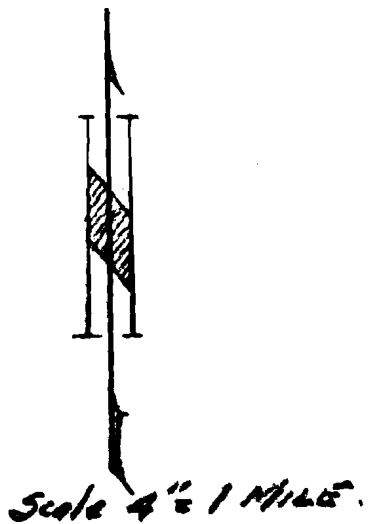


MAP
TO ACCOMPANY WELL APPLICATION
ROSS B+ HAMMOND
Sisters, Ore.

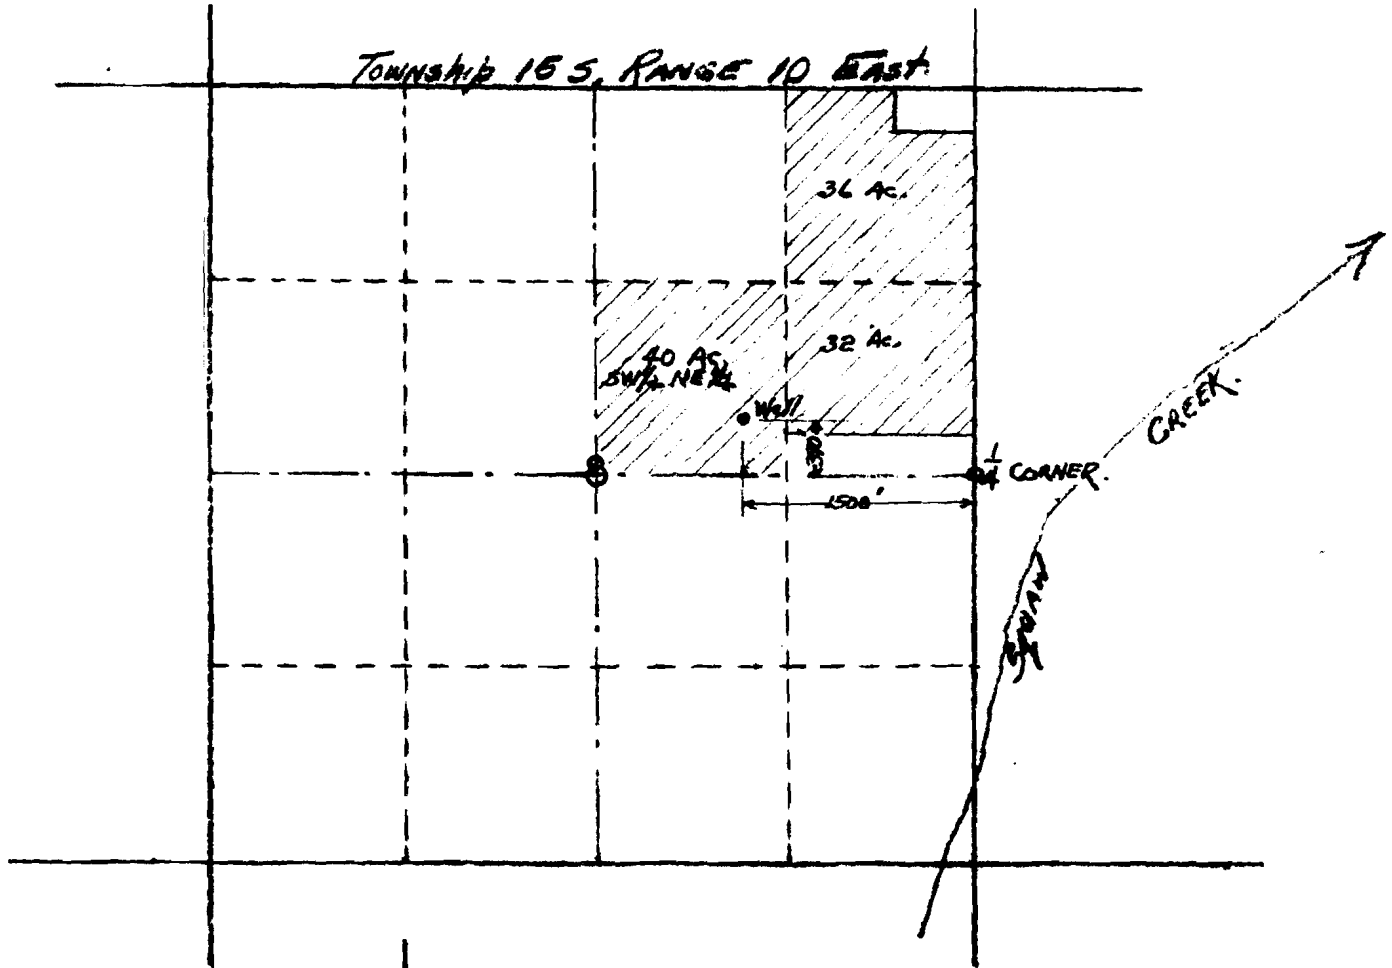

RECEIVED
SEP 9 1953
STATE ENGINEER
SALEM, OREGON

Application No. U-628

U-628-191