


T. 58 & 6 S. R. 2 W. W.M.

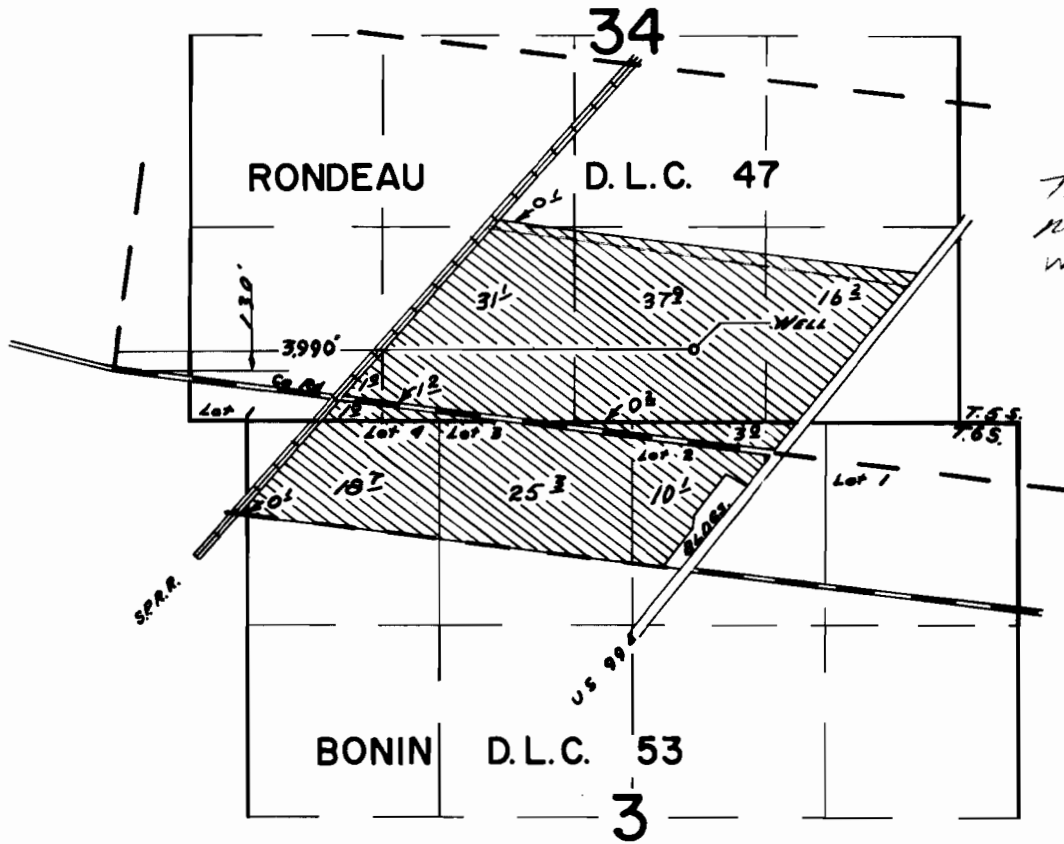

**FINAL PROOF SURVEY**  
UNDER

Application No. G-3912 Permit No. G-3455  
IN NAME OF

JAMES BUTSCH

Surveyed Aug. 15 1972, by R.G. MUSHEN