


G. 7646
T 7382
56538
75627
T 7380

T.26S. R.14E. W.M.

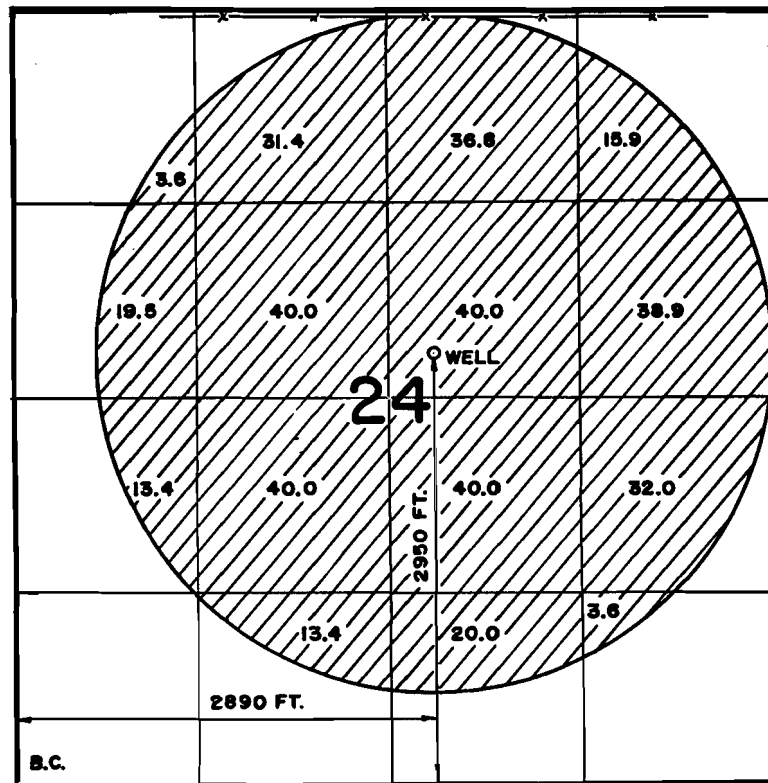

SCALE: 4" = 1 MILE

FINAL PROOF SURVEY
UNDER

Application No. G-8060. Permit No. G-7646.....
IN NAME OF

.....JACK & DORIS KITTREDGE.....

Surveyed OCT. 14., 1984., by P. Patten.....