


11755

Sec. 27
34
Tp. 11 S
R. 35 1/2 E

8200
7563

27

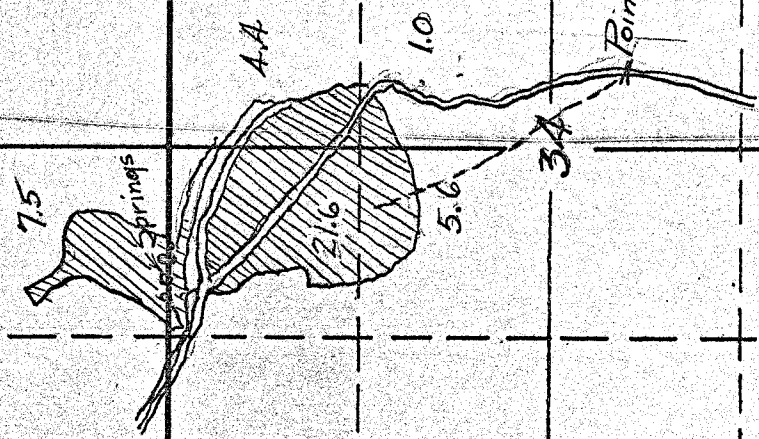

Ap. No. 11755
Per. No. 8200