


T.33&34S.,R.31E., W.M.

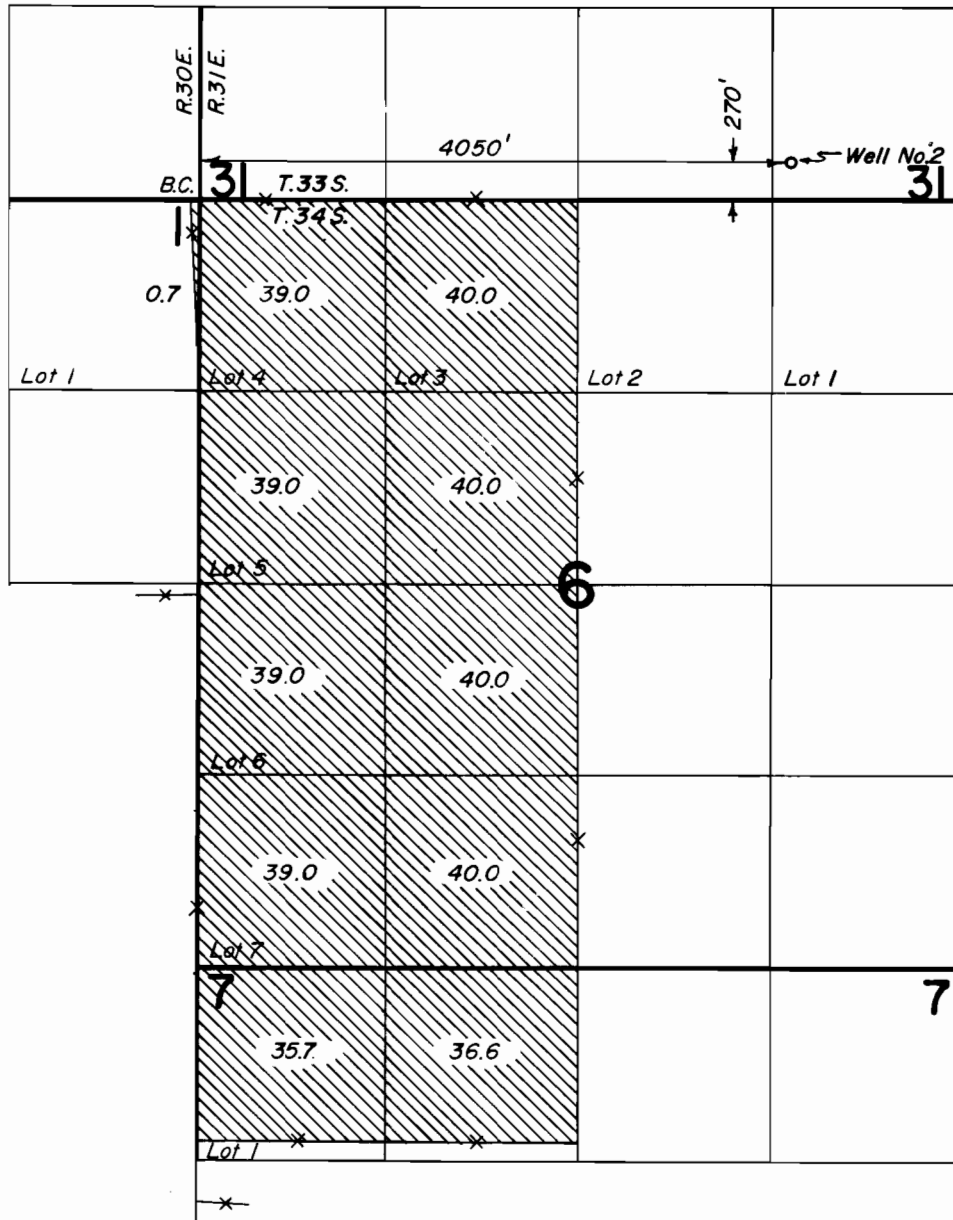

FINAL PROOF SURVEY UNDER

Application No. G-7184 Permit No. G-6616
IN NAME OF

REX CLEMENS

Surveyed AUG. 25, 1978, by R.G. MUCKEN