
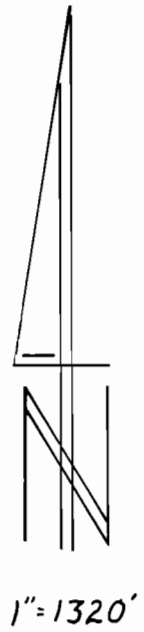


T. 5S. R. 3W. W.M.

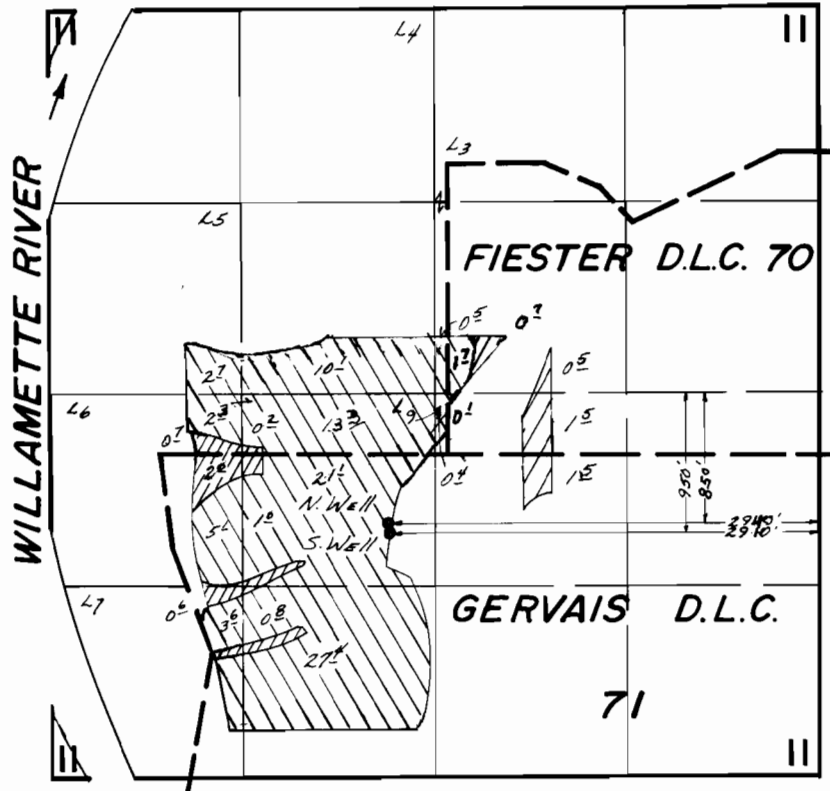

South Well
 PRIMARY
 SUPPL.
 North Well
 PRIMARY

FINAL PROOF SURVEY
UNDER

Application No. G-8872 Permit No. G-8222.
IN NAME OF

MICHAEL W. MAHONY

Surveyed Oct. 3, 1979, by C.R. RODRIGUEZ