


T. 2 S., R. 5 E., W.M.

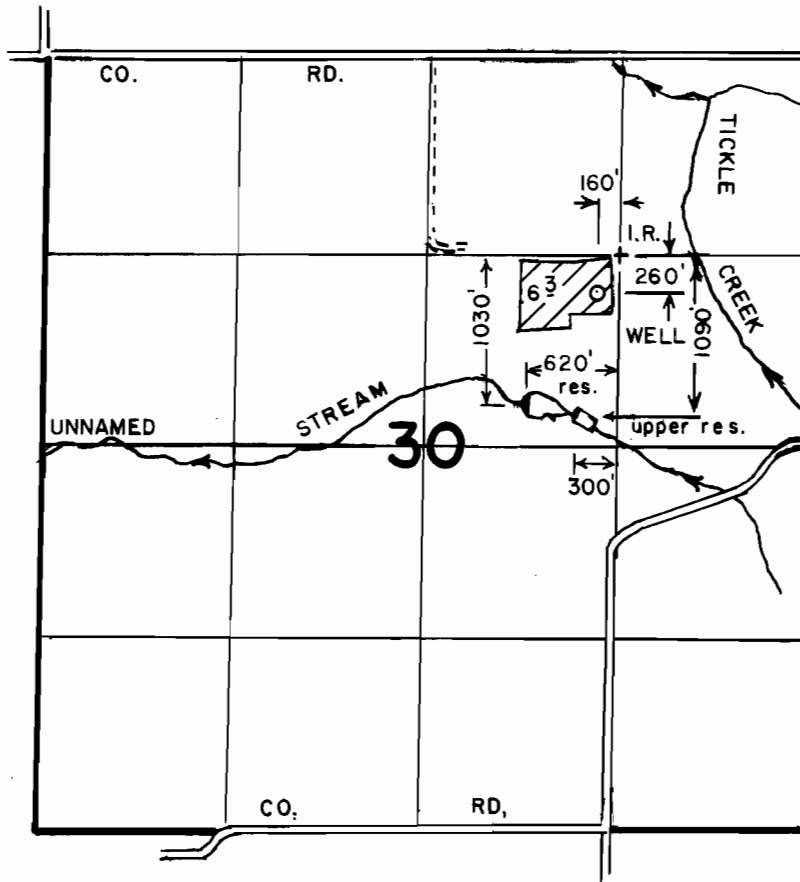

FINAL PROOF SURVEY
UNDER

G-11493 G-10636
68736 49752
Application No. R-68688 Permit No. R-10785
IN NAME OF

DAVID J. SHARP

Surveyed MAY 15, 1990, by T.M. WARREN.