


T.26S., R.6W., W.M.

29

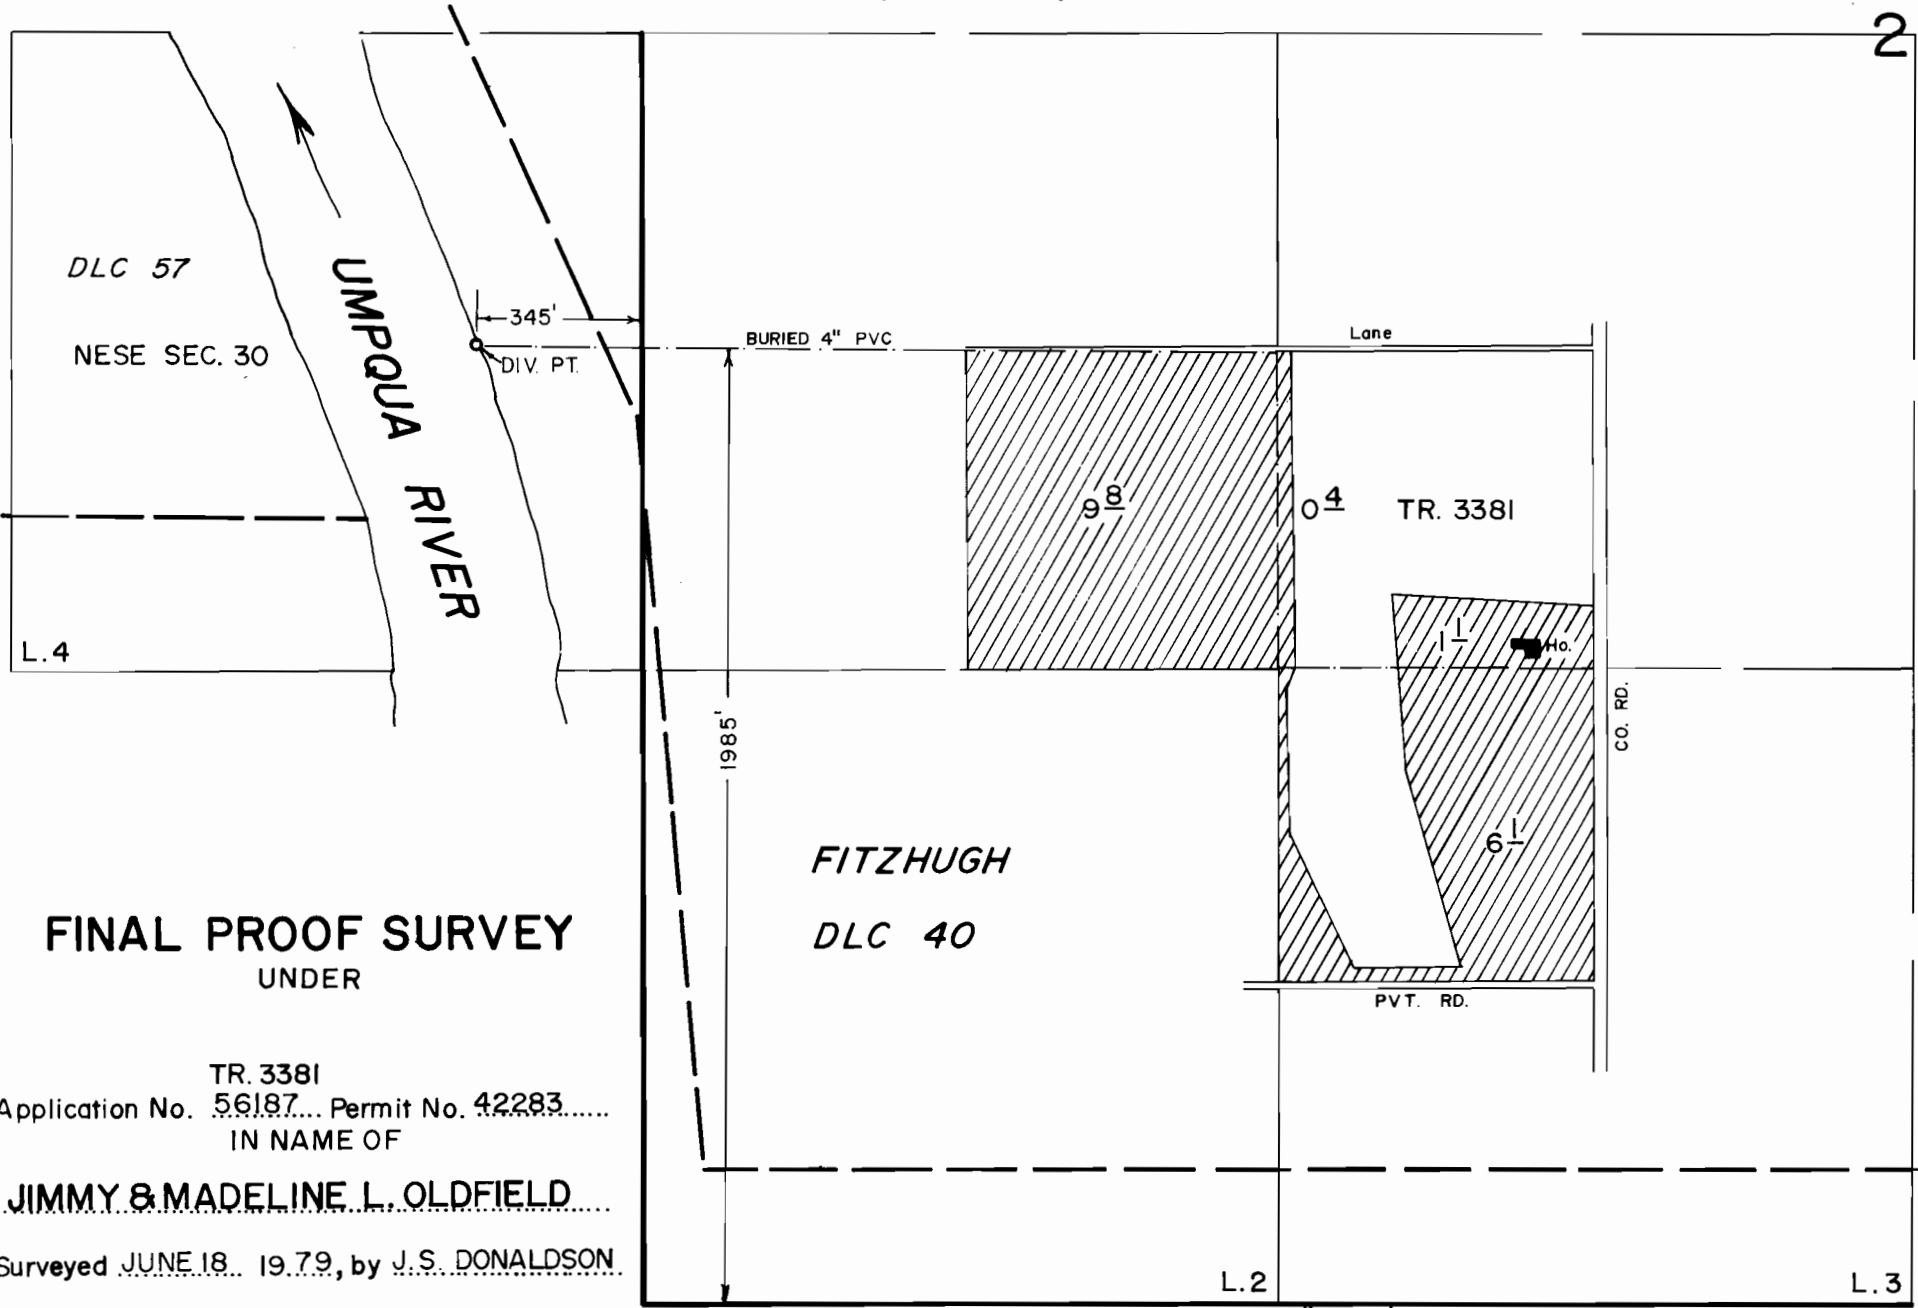

FINAL PROOF SURVEY
UNDER

TR. 3381
Application No. 56187... Permit No. 42283.....
IN NAME OF

JIMMY & MADELINE L. OLDFIELD

Surveyed JUNE 18, 1979, by J.S. DONALDSON

SCALE: 1" = 400'

Bob