


T. 1 N. R. 26 E. W. M.

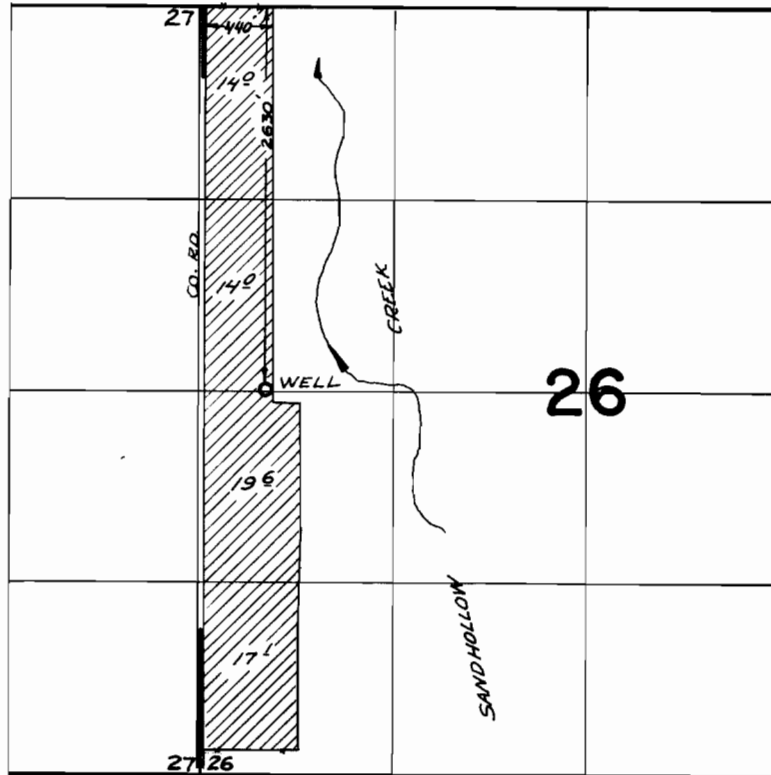

FINAL PROOF SURVEY UNDER

Application No. G-2605.. Permit No. G-2409.
IN NAME OF

KENNETH TURNER

Surveyed *June 21, 1967.*, by *L.E. Gaud*.....