
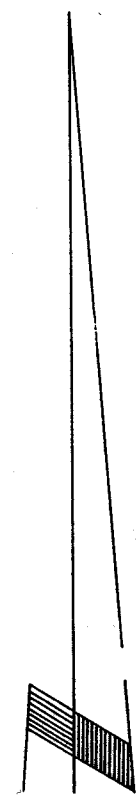


G-4255
T-5016
T-5017
73649

T. 1 N.,
R. 26 E.,
W. M.

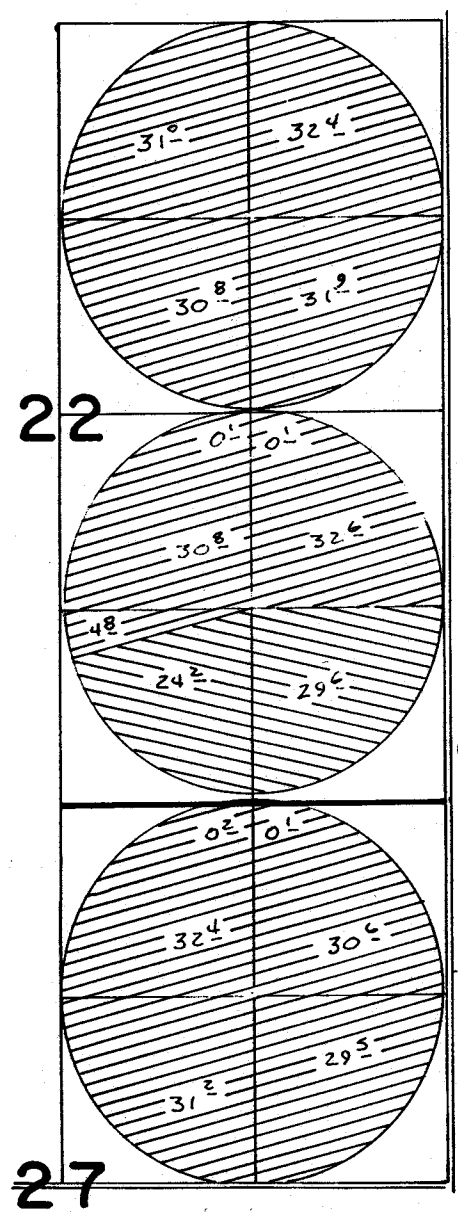

SCALE 1" = 1320'

FINAL PROOF SURVEY

UNDER

TRANSFER 5016

TRANSFER 5017

IN NAME OF

TURNER RANCH, INC.

Surveyed 9 1987, by V. L. Church