


Sec. 5 /

2

Tp. 13 S.

R. 33 E.

in  
Grand Co.,  
Ore.

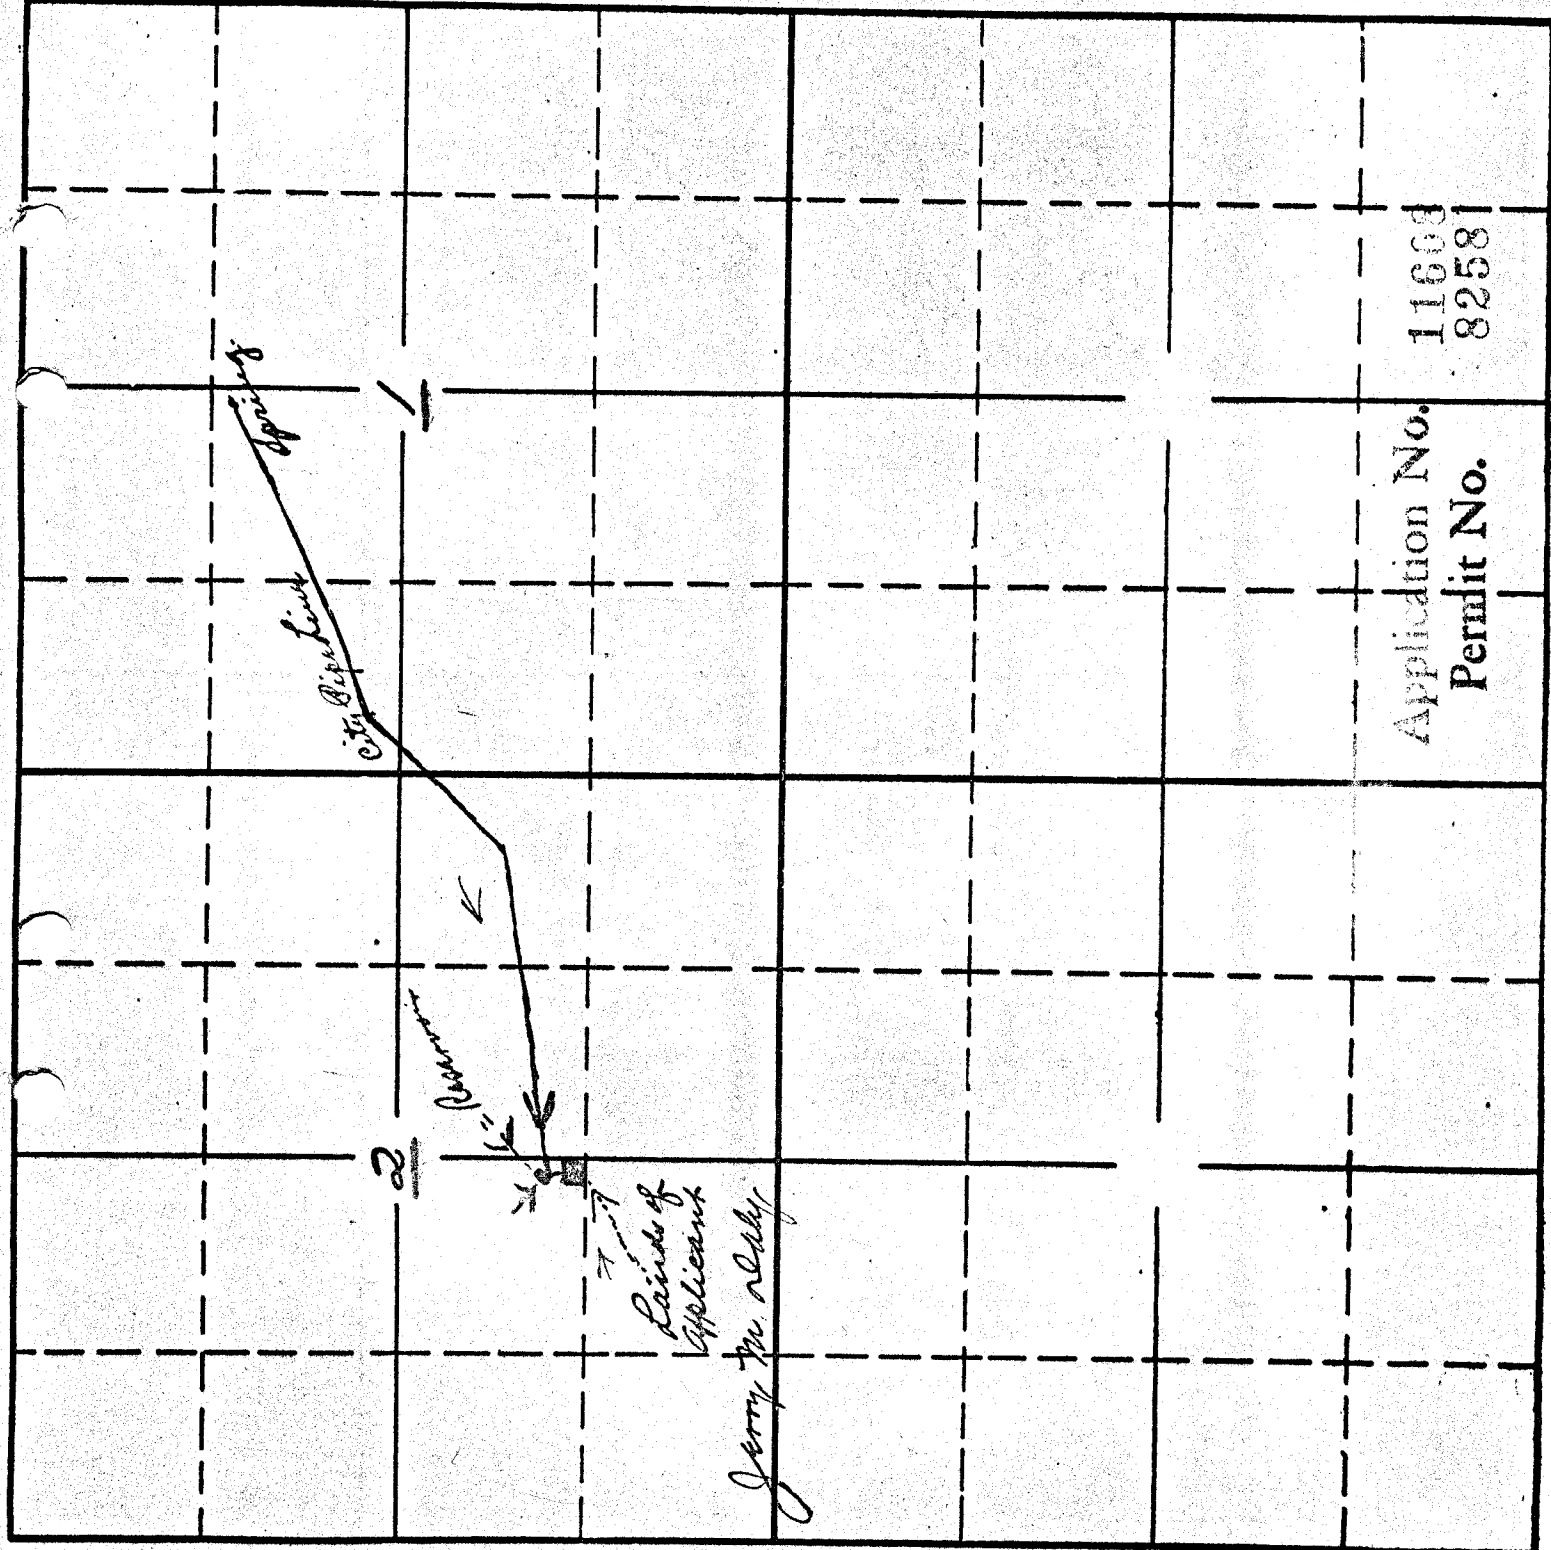

Application No.	11609
Permit No.	8258

