



T.21&22S.,R.5W.,W.M.

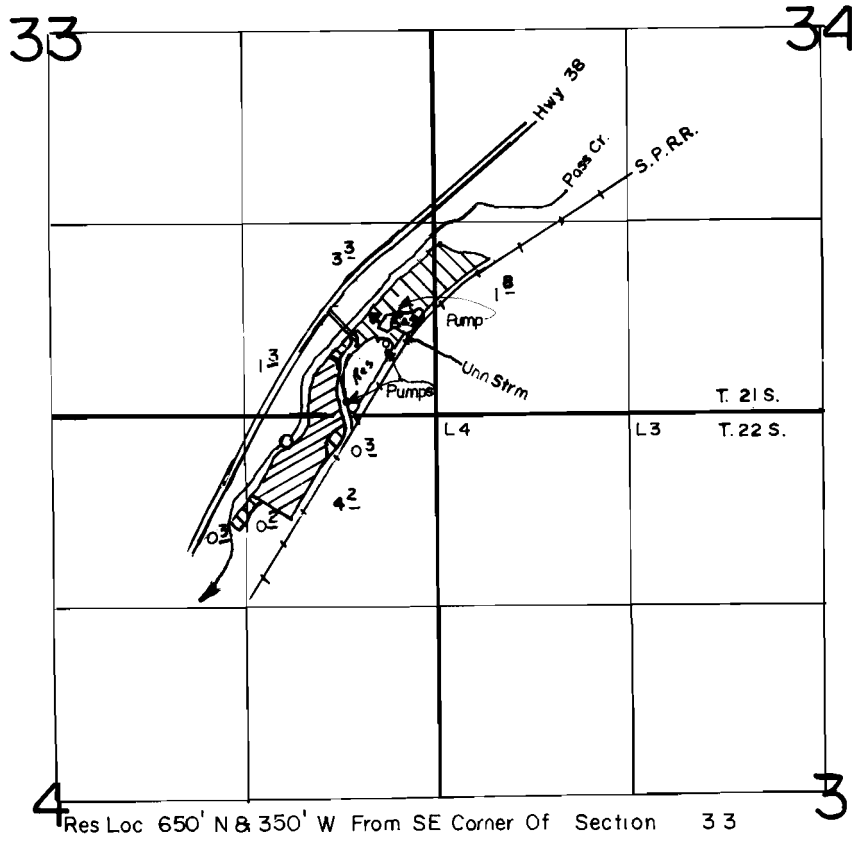

SCALE: 1" = 1320'

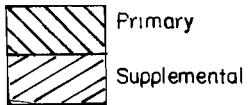

FINAL PROOF SURVEY
UNDER

R-50382 R-6266

Application No. 50383.. Permit No. 39119.....

IN NAME OF

WILLIAM C. & NONDYS V. WOOLEY.....

Surveyed OCT. 1..... 1979., by S. DONALDSON.....