


# T. 6 S. R. 1 W. W. M.

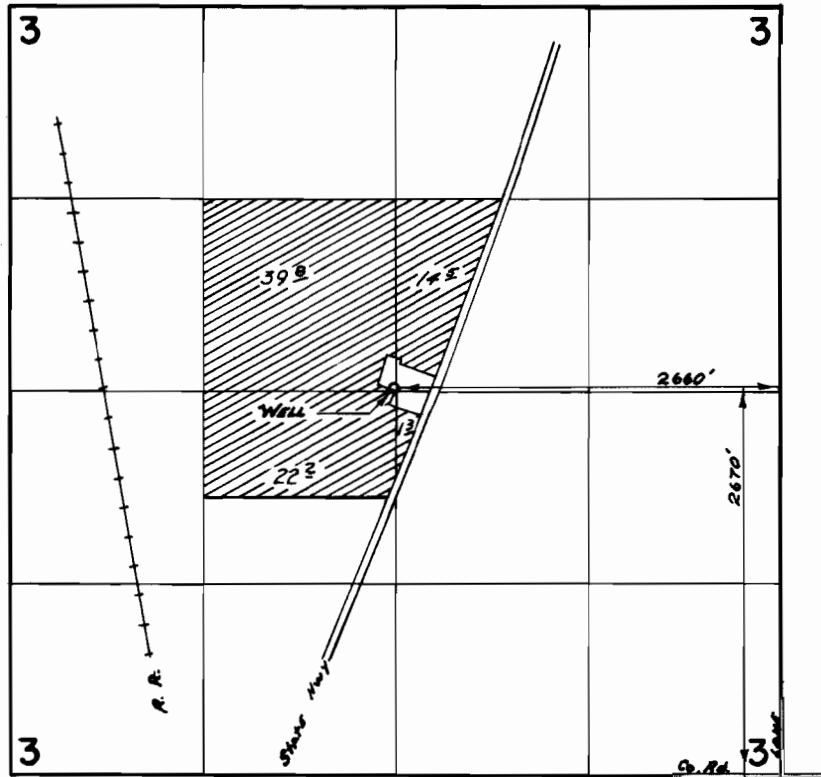

## FINAL PROOF SURVEY UNDER

Application No. G-2525 Permit No. G-4320  
IN NAME OF

CARL ERTELT

Surveyed June 13 1972, by R. G. MUCKEN