


T7393
31032
75659

T.14 & 15S. R.15E.W.M.

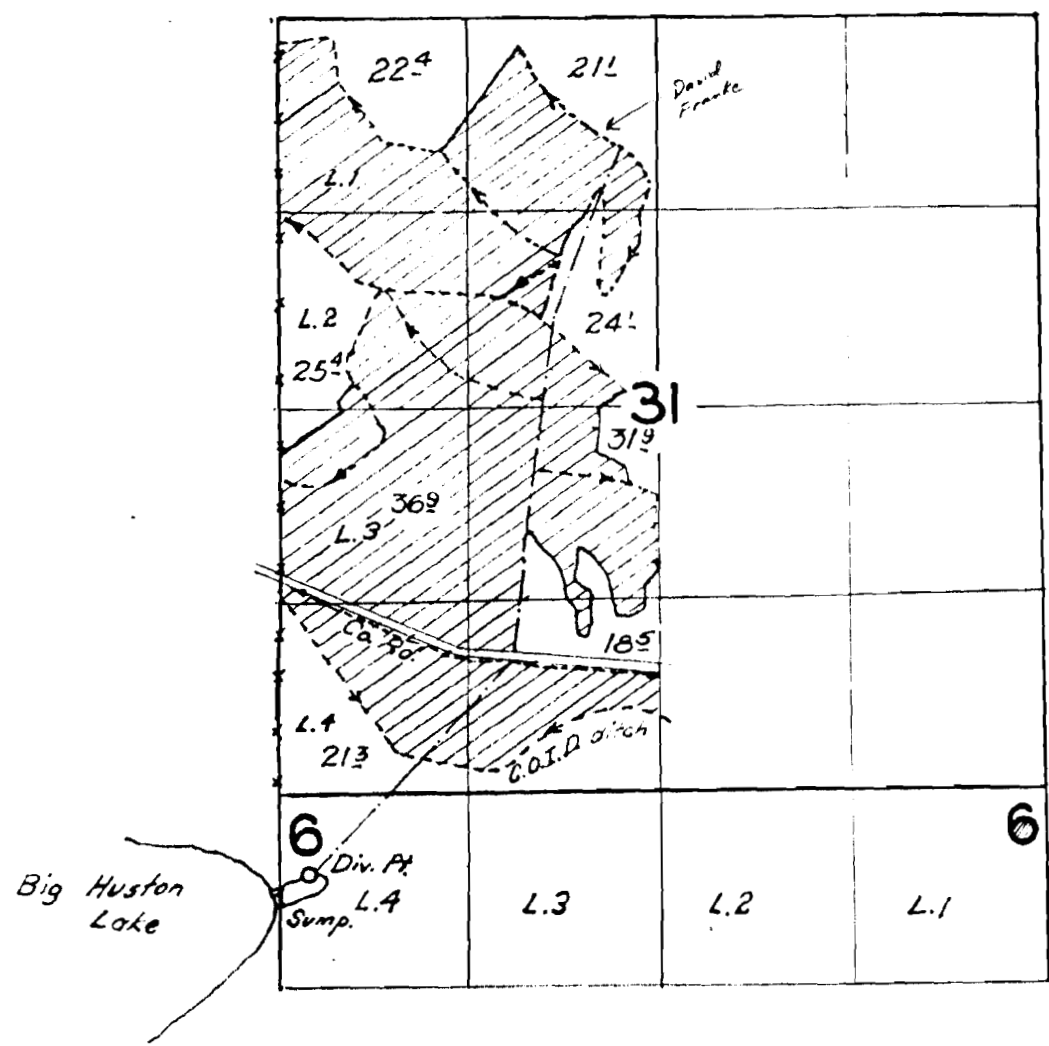

FINAL PROOF SURVEY UNDER

Application No. 29059 Permit No. 22911
IN NAME OF

Wendell A. Gross

Surveyed Oct. 31, 1962, by Carl R. Baker