


T 4 S. R. 3 E. W. M.

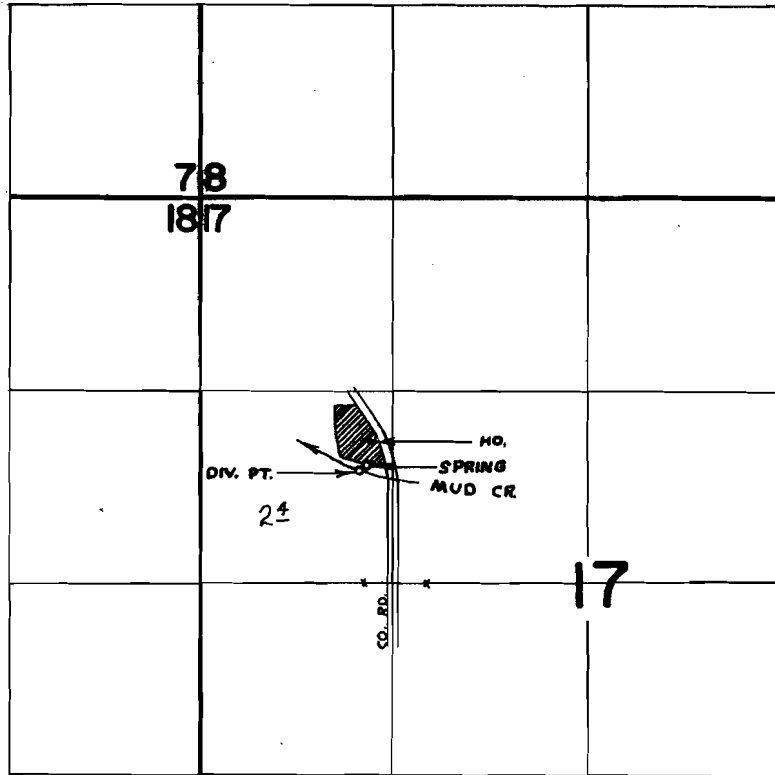

DIV. PTs. LOC. : MUD CR. 770' N & 230' W ; SPR. 810' N 180' W
BOTH FROM SE COR. SW 1/4 NW 1/4 SEC. 17

FINAL PROOF SURVEY UNDER

Application No. 43862 Permit No. 32775
IN NAME OF

.....HENRY W. KOHL.....

Surveyed APR. 30, 1971., by R. MUCKEN.....