


T.18S.R.46E.WM

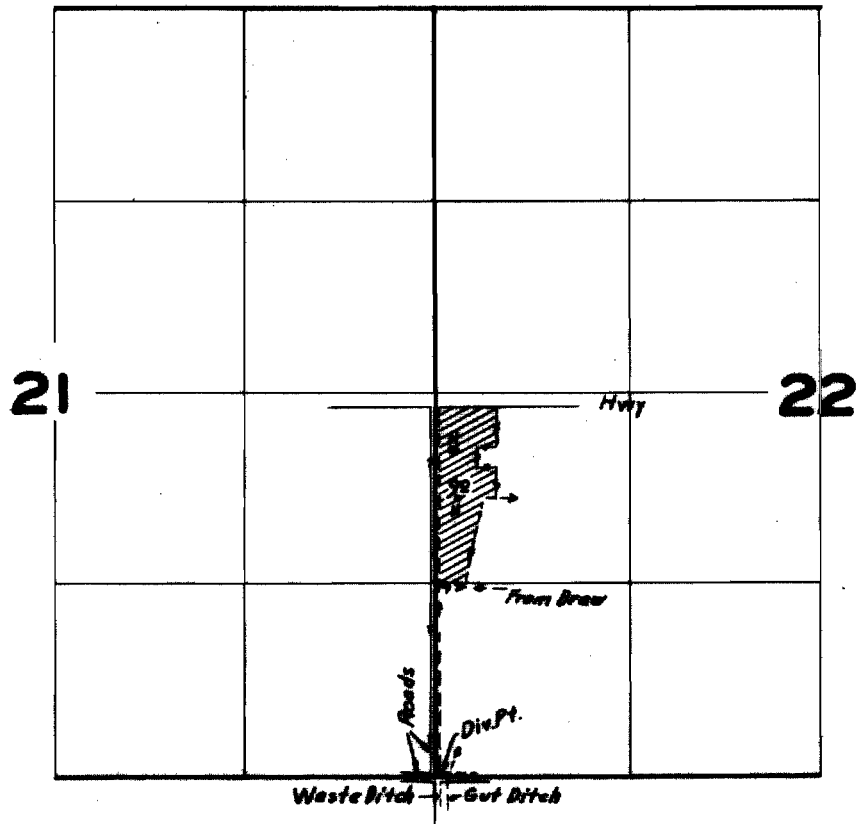

FINAL PROOF SURVEY
UNDER

Application No. 26241 Permit No. 20605
IN NAME OF

..... Fred D. Hawkins

Surveyed July 23, 1953, by H.L. Coffman.....