


T.16S.R.47E.W.M.

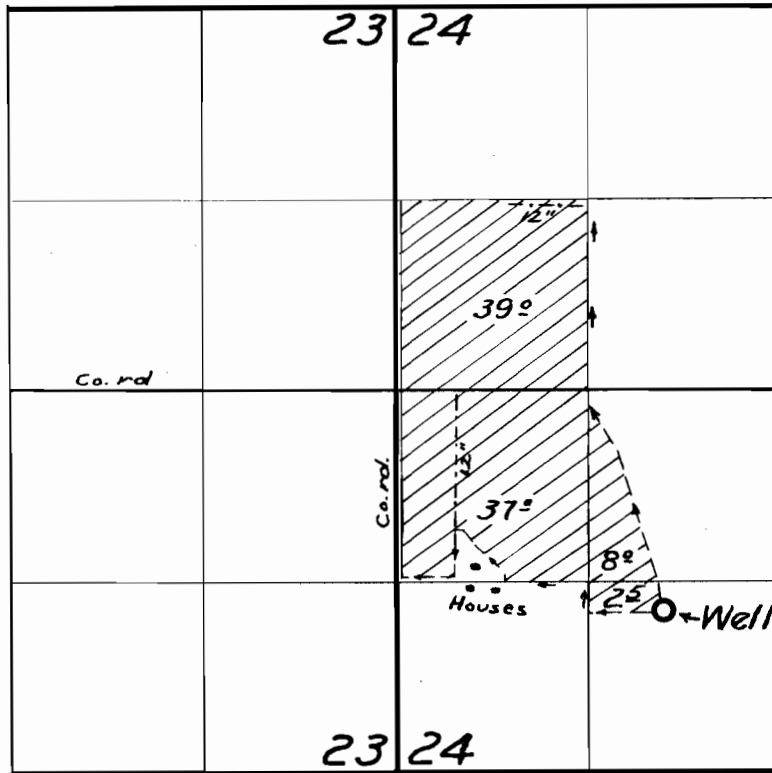

### FINAL PROOF SURVEY

UNDER

Application No. U-679 Permit No. U-627

IN NAME OF

Aye, Toshiko & Masa Nagaki

Surveyed Oct. 11, 1955, by M. Bish