


T.16S. R. 47 E. W.M.

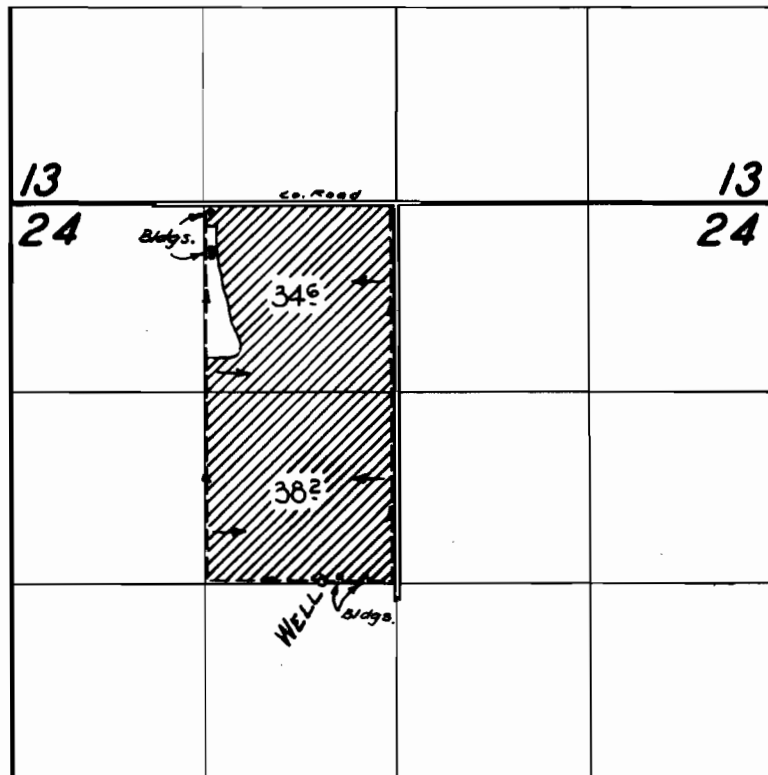

**FINAL PROOF SURVEY**  
UNDER

Application No. G-121... Permit No. G-32...  
IN NAME OF

***TSUTOMU B. & EUGENE H. IMADA***

Surveyed 30 Oct. 1958, by C.O. Bartels.