



T.18 S. R. 46 E.W.M.

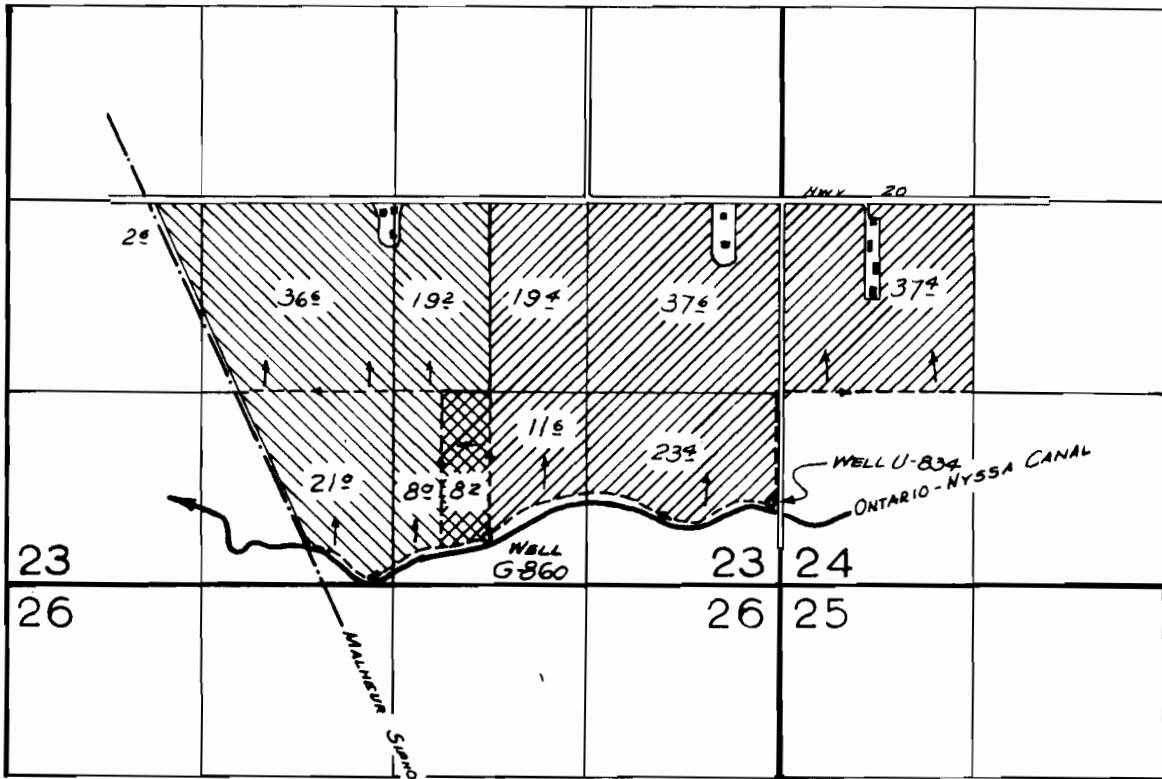

U-834 
 G-860 

FINAL PROOF SURVEY UNDER

Application No. U-834 / G-860 Permit No. U-741 / G-789
 IN NAME OF

MR. KAY TERAMURA

Surveyed Sept. 19 1959, by *RH Jackson*