


T.18 S. R. 46 E. W.M.

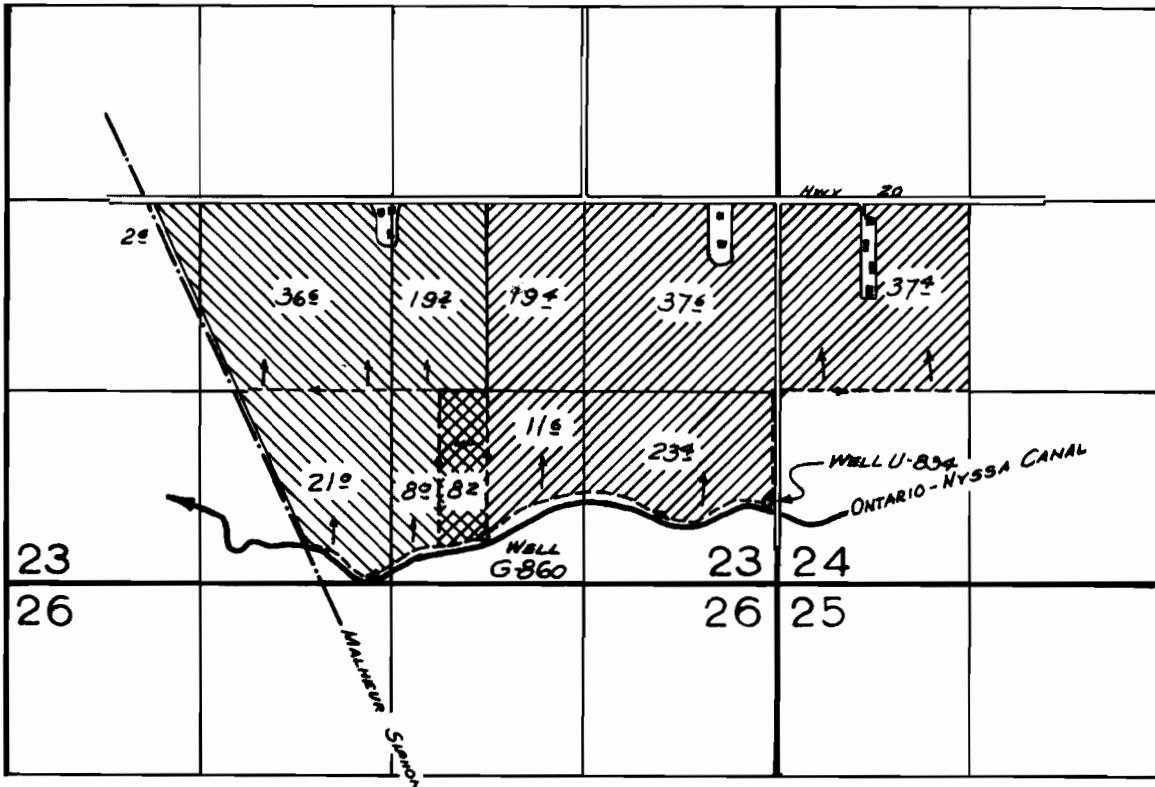

U-834 
 G-860 

FINAL PROOF SURVEY
 UNDER

Application No. U-834 Permit No. U-741
 G-860 G-789
 IN NAME OF

MR. KAY TERAMURA

Surveyed Sept. 19 1959, by *R.H. Jackson*