


T.18S. R.46E. W.M.

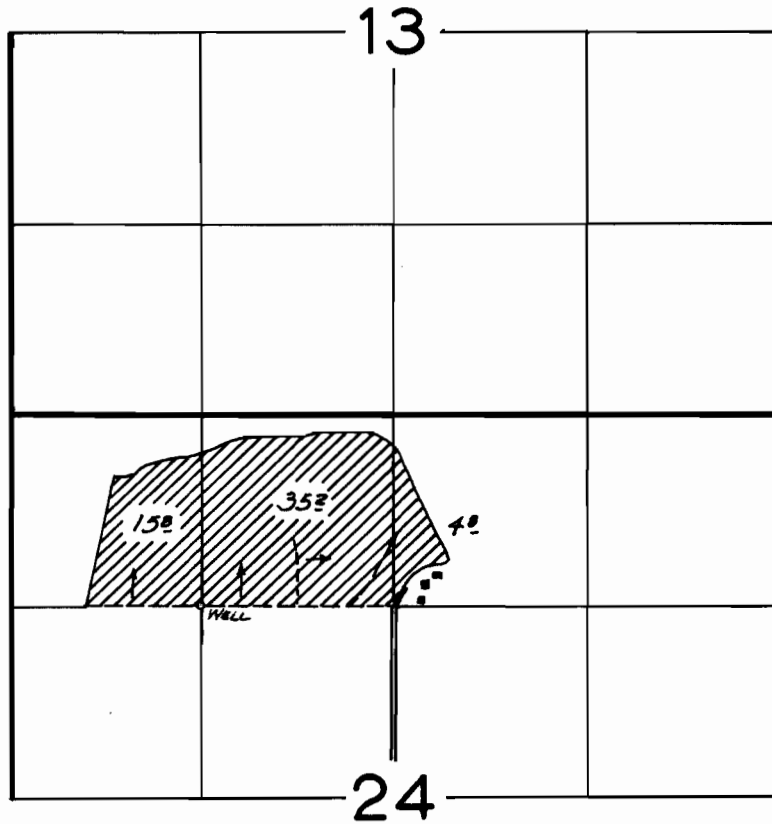

**FINAL PROOF SURVEY**  
UNDER

Application No. G-78 Permit No. G-13  
IN NAME OF

LAWRENCE J. MAROSTICA

Surveyed Sept. 26 1959, by R. Jackson