


T.18S.R.46E.W.M.

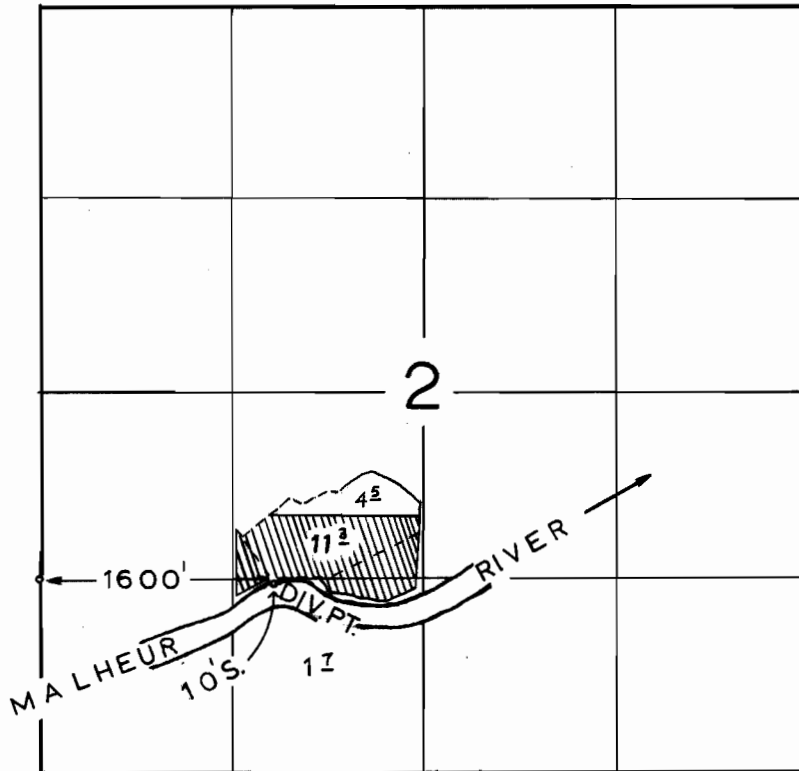

FINAL PROOF SURVEY
UNDER


Application No. 39601 Permit No. 29516

IN NAME OF

S. C. CHANDLER

Surveyed OCT. 23, 1967, by F. ELFERING

T.18S.R.46E.W.M.

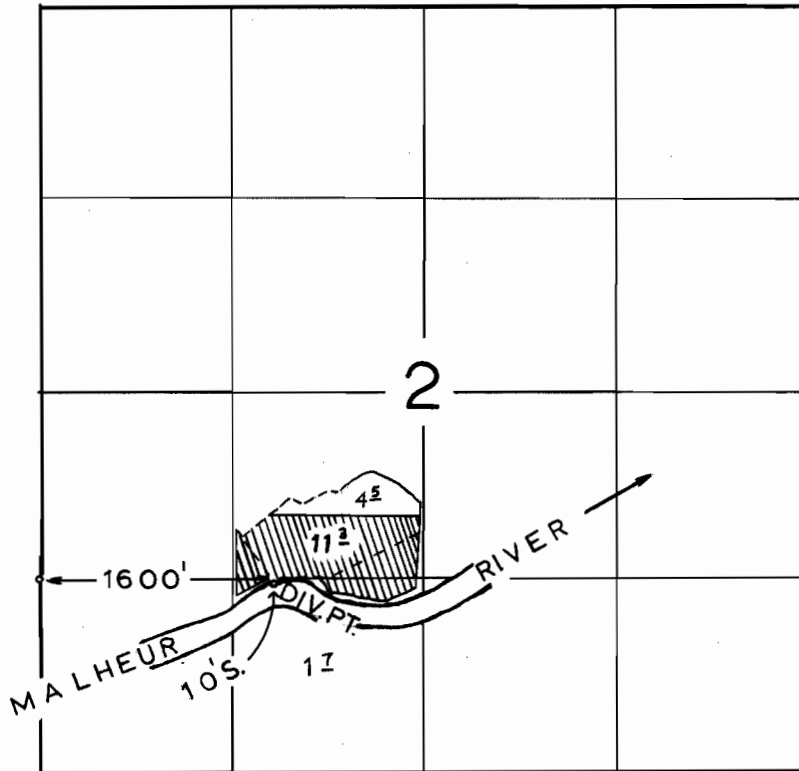

FINAL PROOF SURVEY
UNDER

Application No. 39601 ... Permit No. 29516

IN NAME OF

S. C. CHANDLER

Surveyed OCT. 23, 1967, by F. ELFERING