


T.18S.R.46E.W.M.

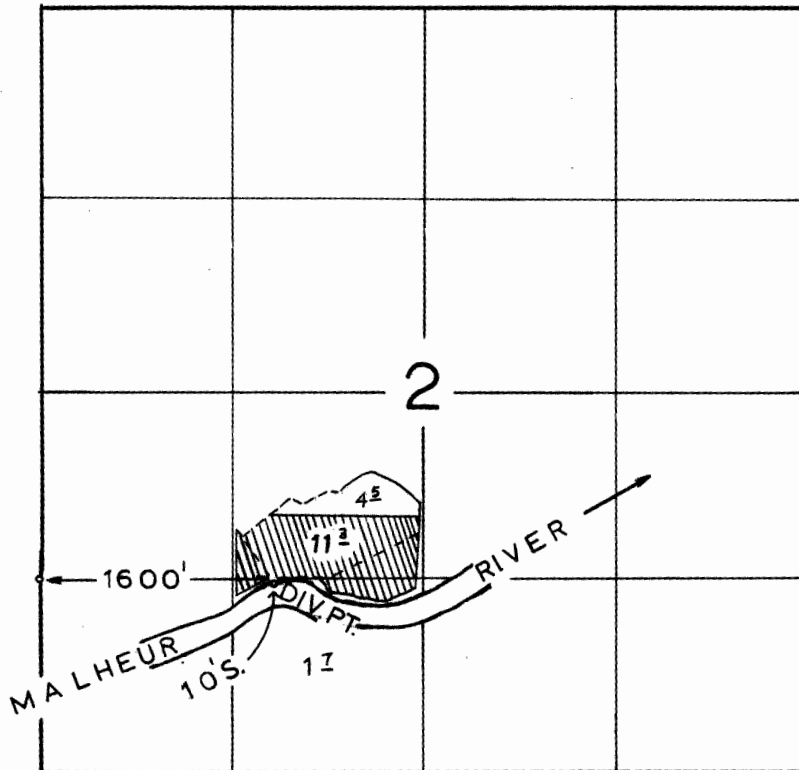

FINAL PROOF SURVEY
UNDER

Application No. 39601 Permit No. 29516

IN NAME OF

S. C. CHANDLER

Surveyed OCT. 23, 1967, by F. ELFERING