
T. 18S.R. 46 E.W.M.

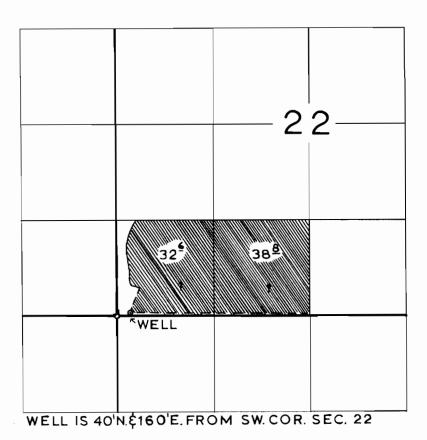

FINAL PROOF SURVEY

Application No. G-3378 Permit No. G-3178 IN NAME OF

ROY J. NELSON

Surveyed MAR. 13 1969, by F.ELFERING