


# T. 18 S.R. 46 E.W.M.

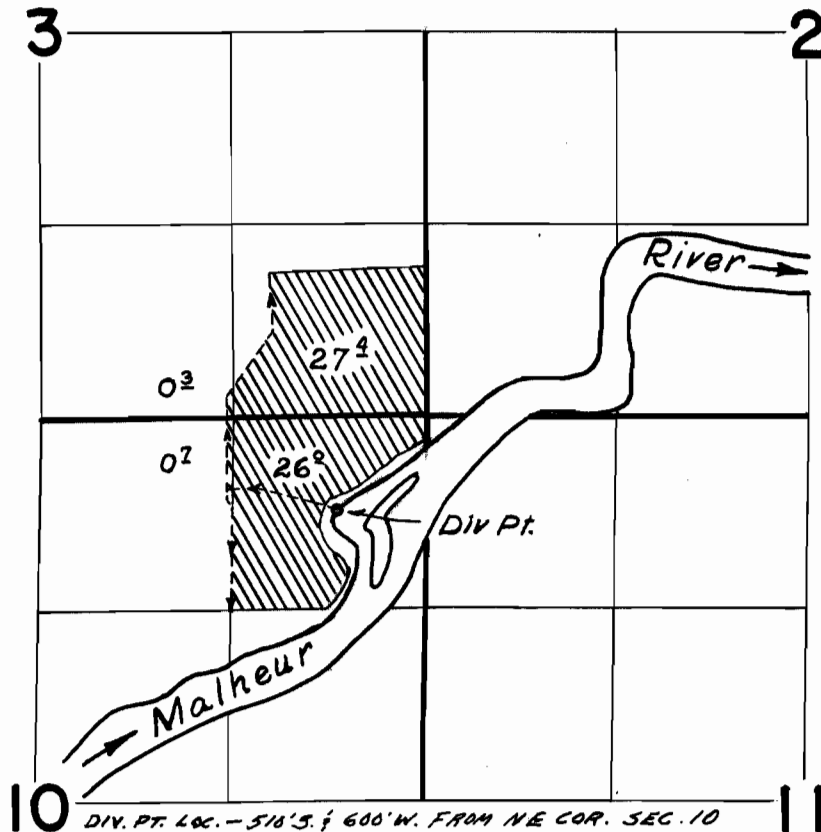

## FINAL PROOF SURVEY UNDER

Application No. 32867 Permit No. 26006  
IN NAME OF

**JOHN F. & CATHERINE E. JACKSON**

Surveyed June 12 1962, by C.R. Baker  
Inspected - Oct. 24, 1978 by B.A. ESTES