


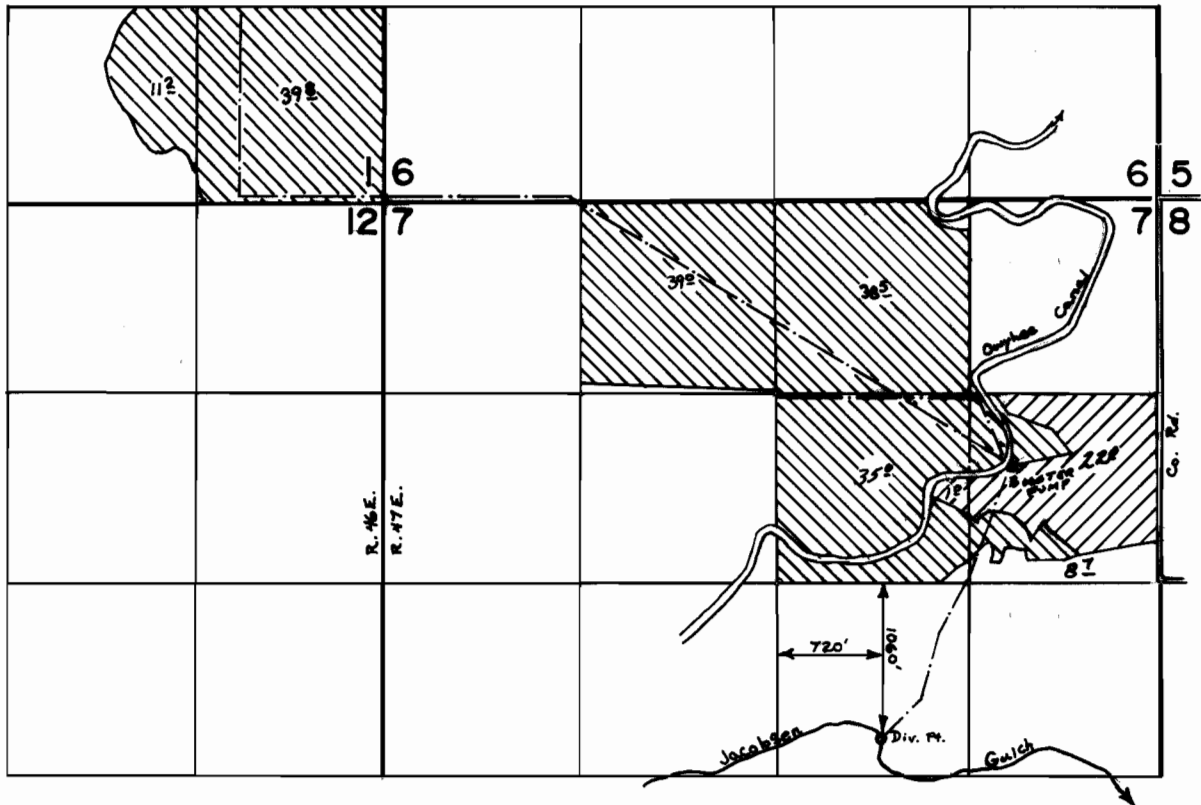

T.17S., R.46 & 47E., W.M.



 Primary
 Supplemental
 To owyHEE

FINAL PROOF SURVEY UNDER

Application No. 46958 Permit No. 37274
IN NAME OF

MERLE MAINE

Surveyed OCT. 19 1977, by J.S. DONALDSON