


To Accompany Application of
Philip E. Leffler

T. 11 S. R. 12 E. W.M.

7876
P-5043

A-7876
P-5043.

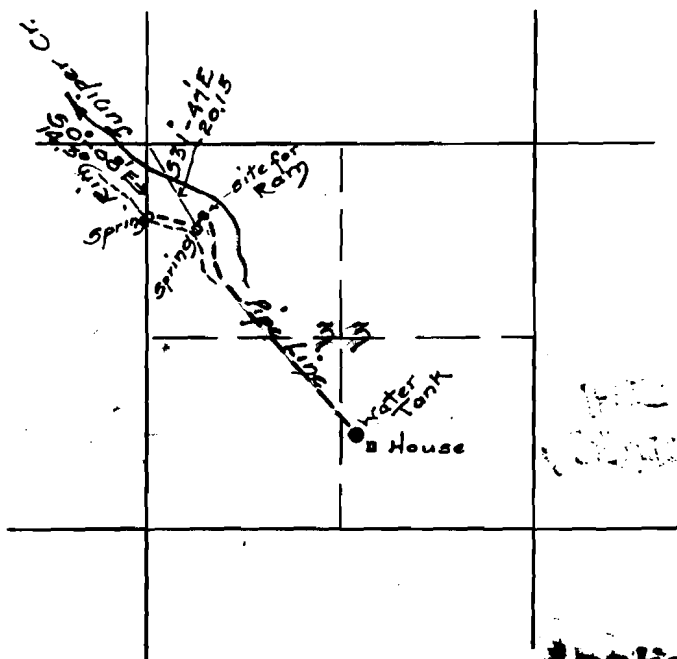

MAY 7

Application No. 6107
Permit No. 3796

Scale 1" = 40 ch.

I, Walter M. Eaton, of Madras, Oregon, do hereby certify that this map was made from notes taken during an actual survey made by me May 6, 1918 and that it correctly represents the works described in the accompanying application, together with the location of streams in the immediate vicinity

Walter M. Eaton
County Surveyor.

P/O