


# T.16S., R.47E., W.M.

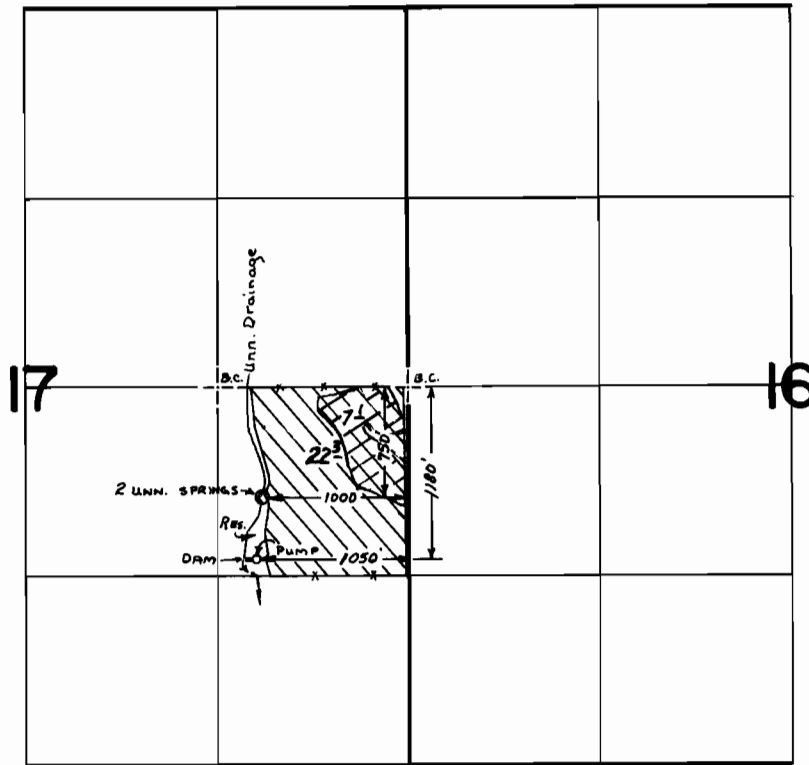

PRIMARY  SUPPLEMENTAL 

## FINAL PROOF SURVEY UNDER

Application No. 56696 R-56816 Permit No. 42862 R-7026.....  
IN NAME OF

.....DVA.....

Surveyed Aug. 19. 19.83., by L.M. TOLL.....