


# T.16S.,R.47E.,W.M.

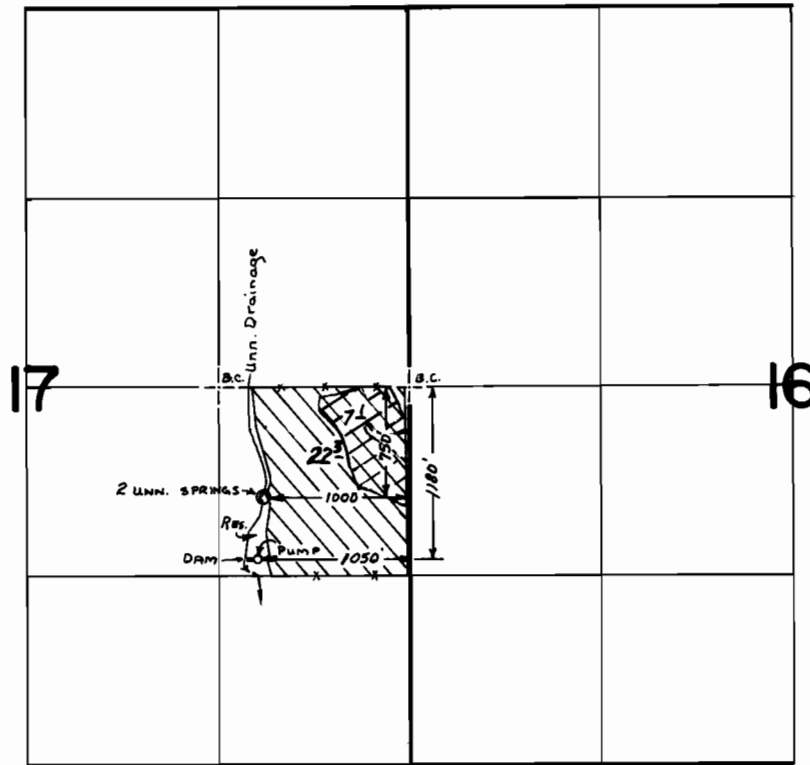

PRIMARY 

SUPPLEMENTAL 

## FINAL PROOF SURVEY UNDER

Application No. 56696 R-56816 Permit No. 42862 R-7026.....

IN NAME OF

DVA

Surveyed Aug. 19. 19.83., by L.M. TOLL.....