


T. 20 S., R. 46 E., W.M.

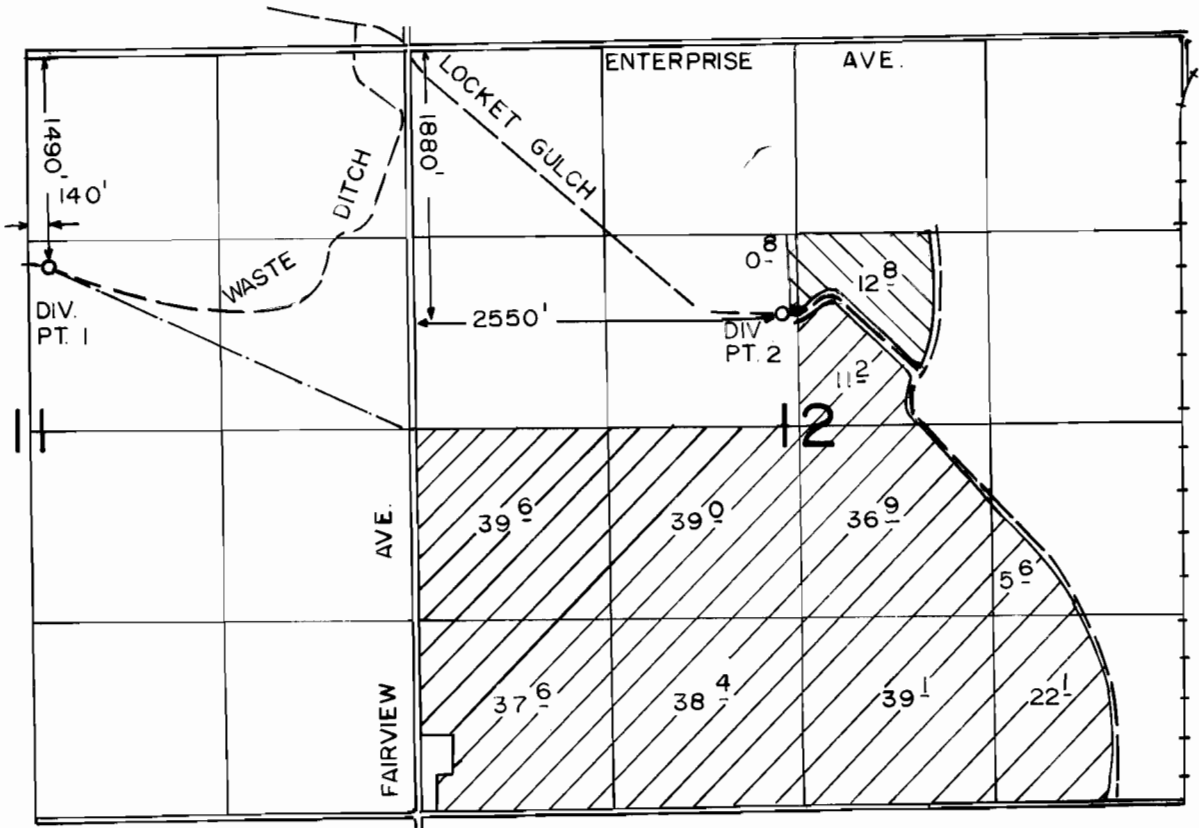

1" = 1320'

SUPPLEMENTAL IRRIGATION

 DIV PT 1

 DIV PT 2

FINAL PROOF SURVEY
UNDER

Application No. 68746 Permit No. 49889
IN NAME OF

CHARLES WARREN FARMER JR. & JAMES GERALD FARMER

Surveyed 6-18-90 19⁹⁰, by K. RISE

2695

1-4-91 DSM
41045-478-23A
BBC-IN-134