


T.27S. R.6W.W.M.

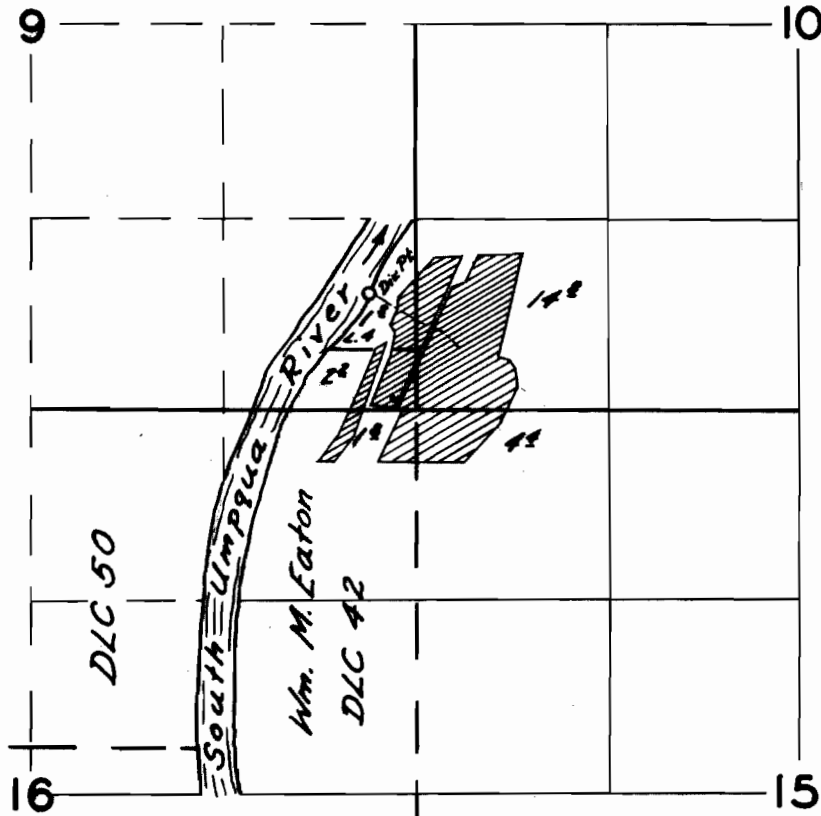

FINAL PROOF SURVEY

UNDER

Application No. *17559* Permit No. *13132*

IN NAME OF

Ben F. Jones

R. A. Hastings & Oscar N. Redenko

Surveyed *Aug. 10, 1956*, by *C. O. Bartels*