


T28SR14WWM

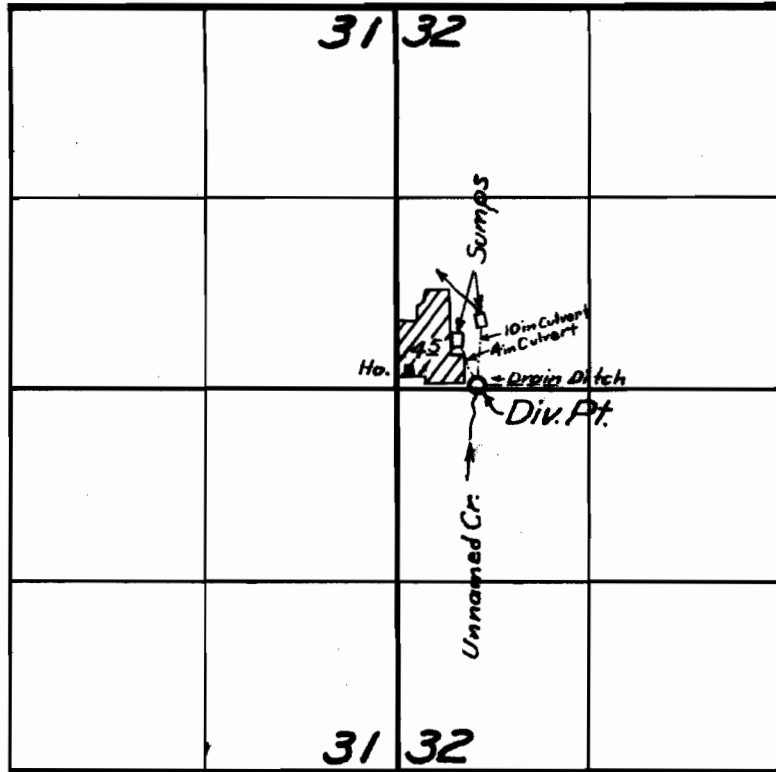

FINAL PROOF SURVEY

UNDER

Application No. 23631 Permit No. 18645
IN NAME OF

Walter G. Houghtaling

Surveyed Aug. 17 1955, by M. Bish