



Sec. 3
4
9
10
Tp. 8S
R. 3W

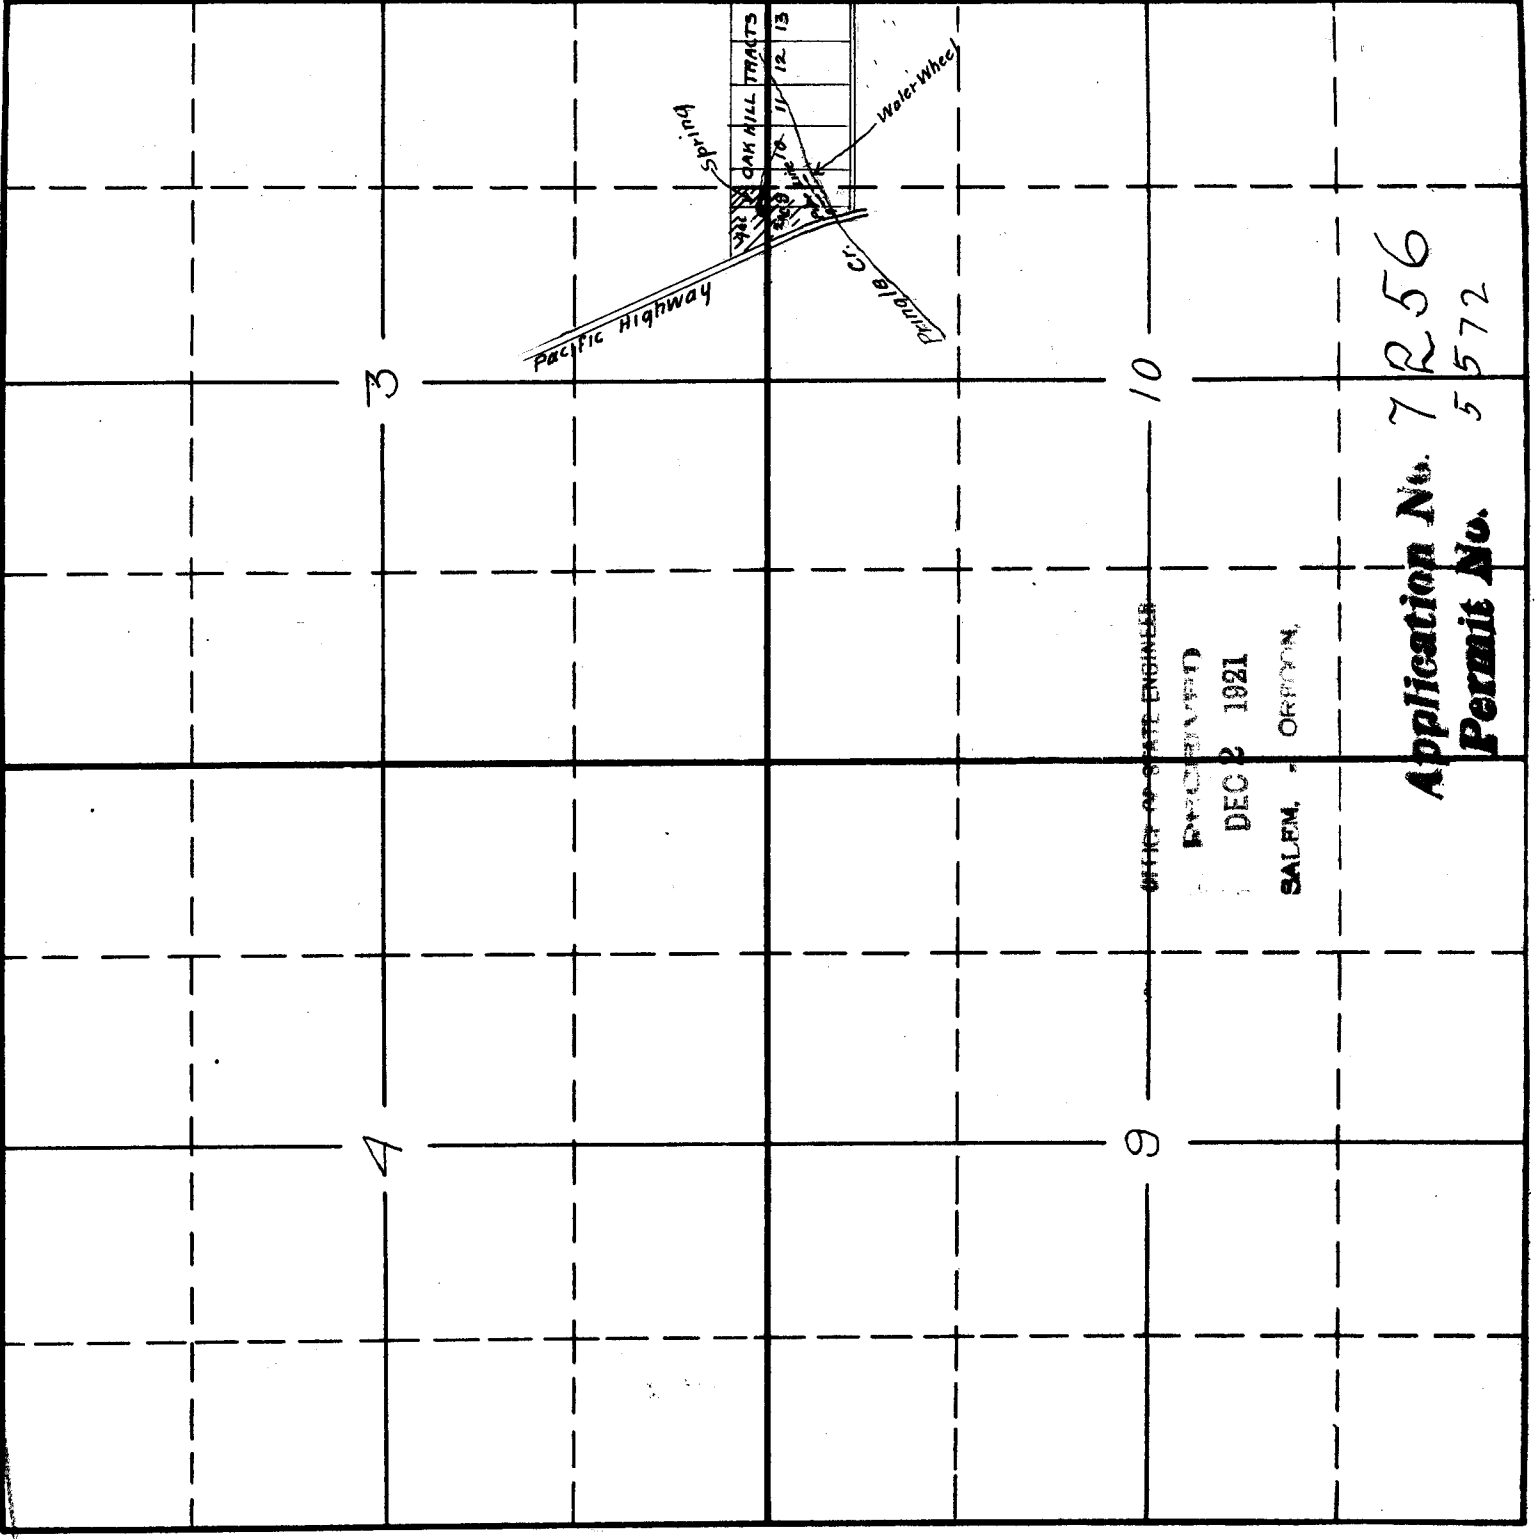

OFFICE OF STATE ENGINEER
 RECEIVED
 DEC 2 1921
 SALEM, OREGON

Application No. 7256
 Permit No. 5572