



T.4S., R.1E., W.M.

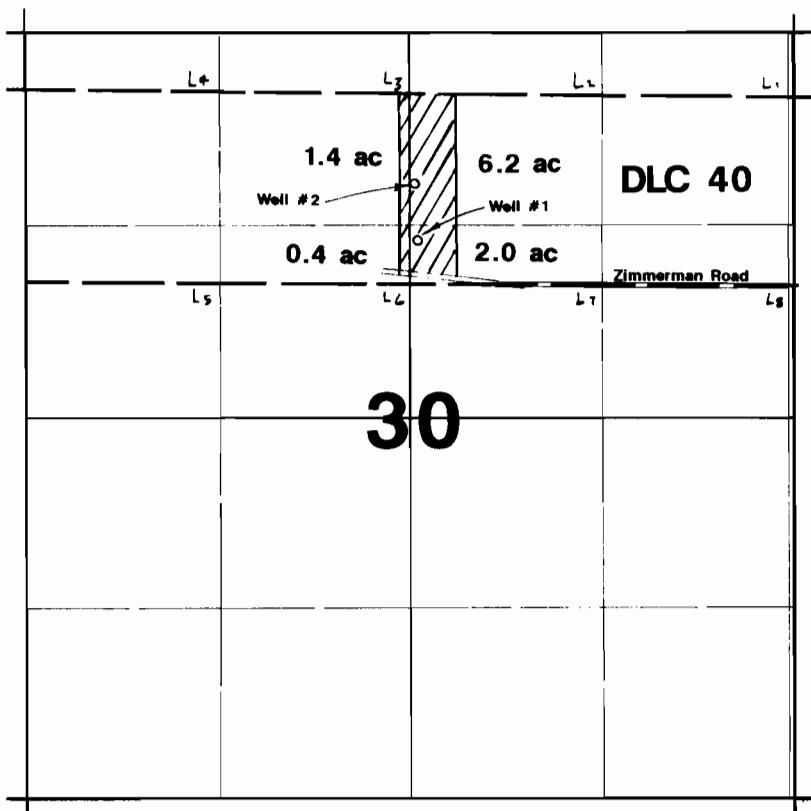

Well #1 located 1430'S & 45'E

Well #2 located 1055'S & 35'E--both from the N¼ corner Section 30.

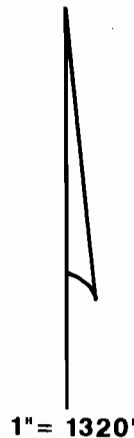

RECEIVED

OCT 13 1997

WATER RESOURCES DEPT
SALEM, OREGON

Final Proof Survey

Application #: G-12696 Permit #: G-11654

In Name Of

Arthur G. & Terri L. Bell

Surveyed on October 6, 1997 by JM Schuette

THIS MAP WAS PREPARED FOR THE PURPOSE OF IDENTIFYING THE LOCATION OF A WATER RIGHT ONLY AND IS NOT INTENDED TO PROVIDE LEGAL DIMENSIONS OR LOCATION OF PROPERTY OWNERSHIP LINES.

