


T.16S. R.43E.W.M.

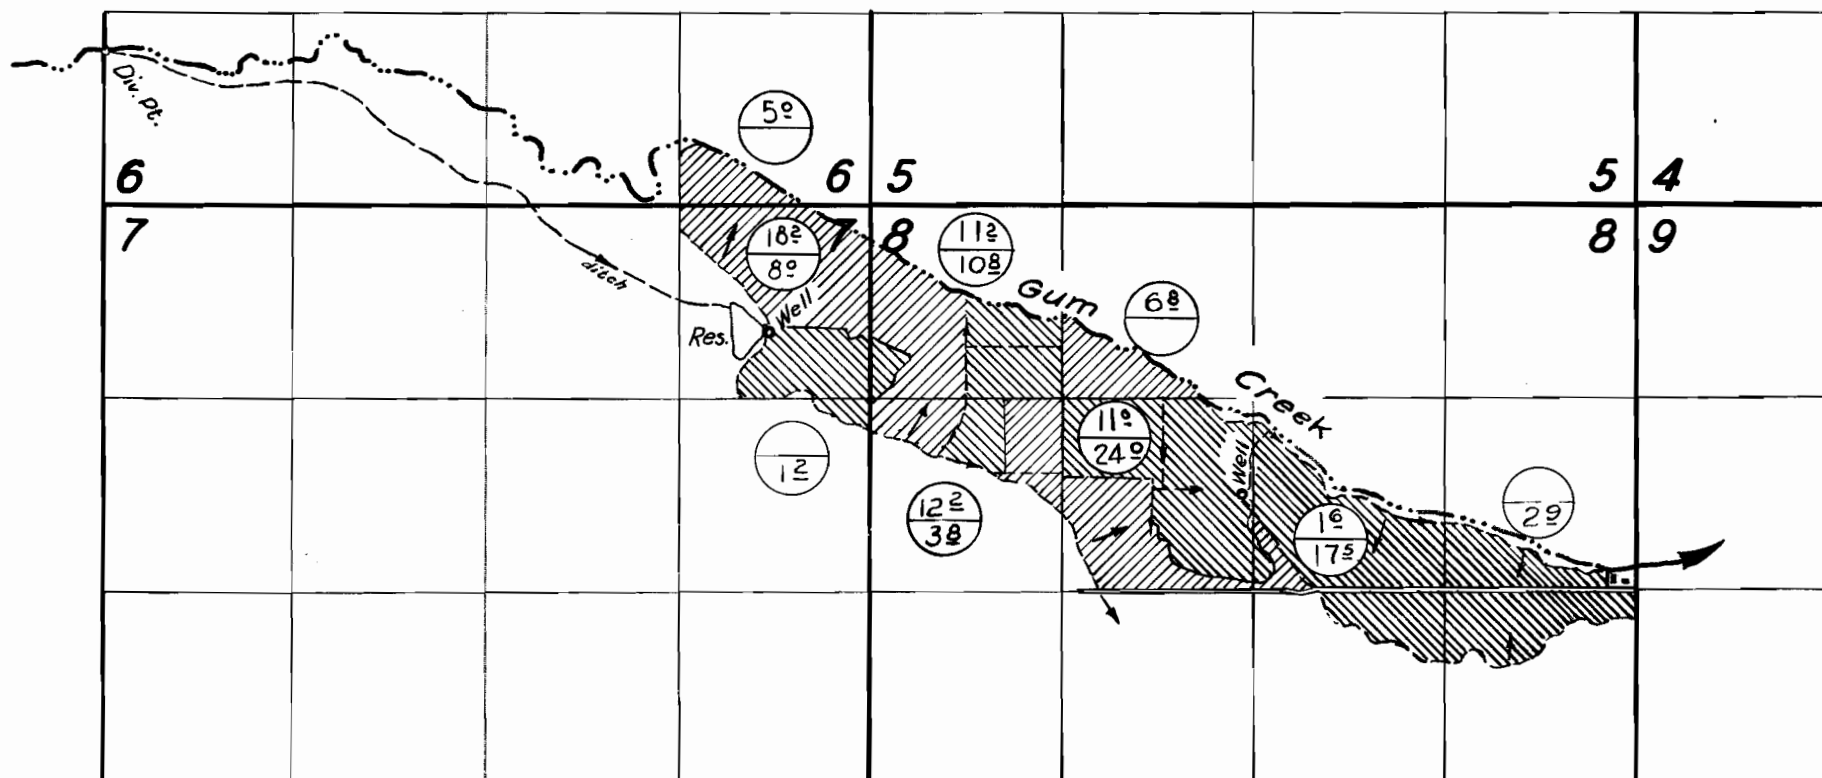

Primary 
Supplemental 

REAL PROOF SURVEY

UNDER

No. 27611, Perm. No. 21750

IN NAME OF

HERBERT M. SHAW

14 Oct. 1958, by C.O. Bartels

BBC-8N-80
BBC-8N-118