


T.37S.R.1W.W.M.

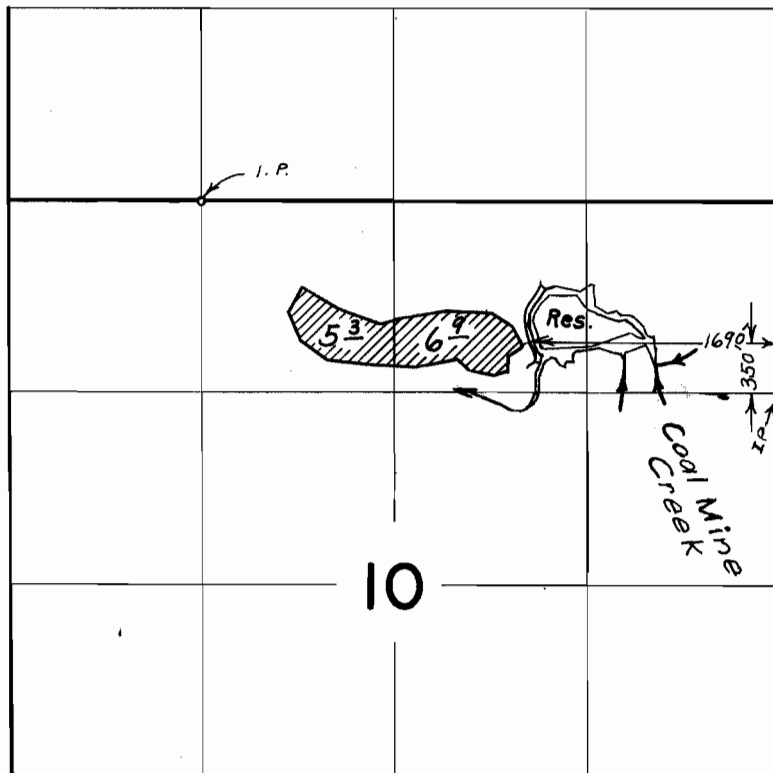

FINAL PROOF SURVEY
UNDER

Application No. R-29362 29363 Permit No. R-1683 23238
IN NAME OF
FRED W. NELSON

Surveyed July 26, 1967, by L.E. Gould