


T19S. R25E. WM.

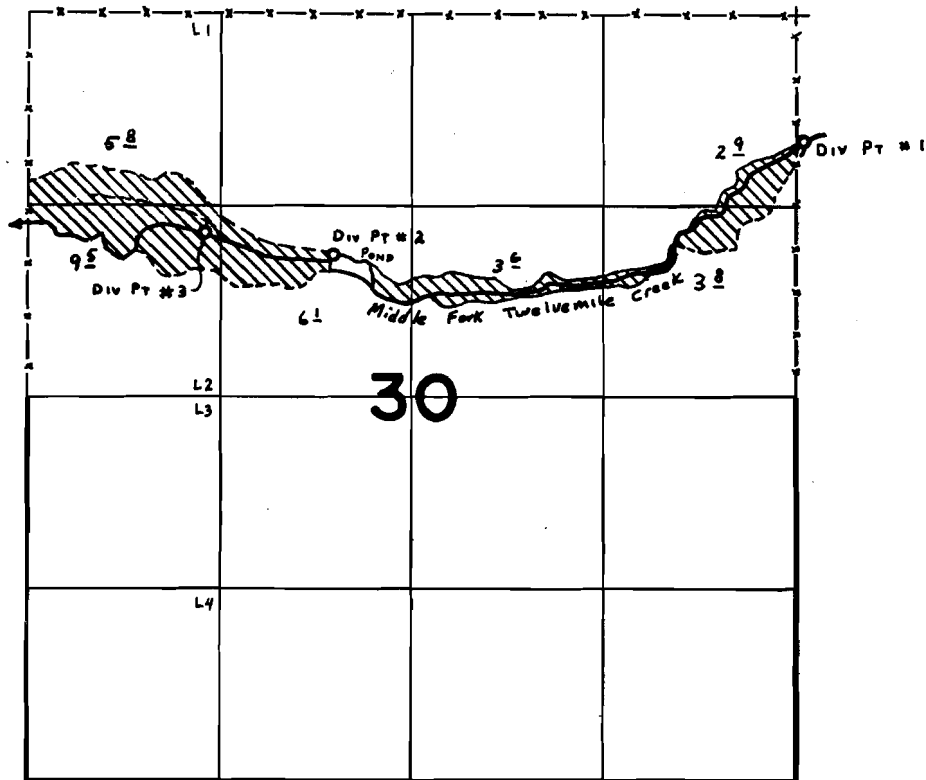

Div Pts Loc { #1 - 870'S. & 40'E. } ALL FROM NE COR. SEC. 30.
 { #2 - 1650'S. & 3180'W. }
 { #3 - 1500'S. & 4070'W. }

FINAL PROOF SURVEY UNDER

Application No. 43278 Permit No. 32346
 IN NAME OF

CRISLEY BURGER

Surveyed AUG. 28 1978, by C. L. HUGHES

T7158
 51660
 75727
 T7158
 32346
 PTS-1978-H