


26-648
27017
75731

T.27 S.R.16 E.W.M.

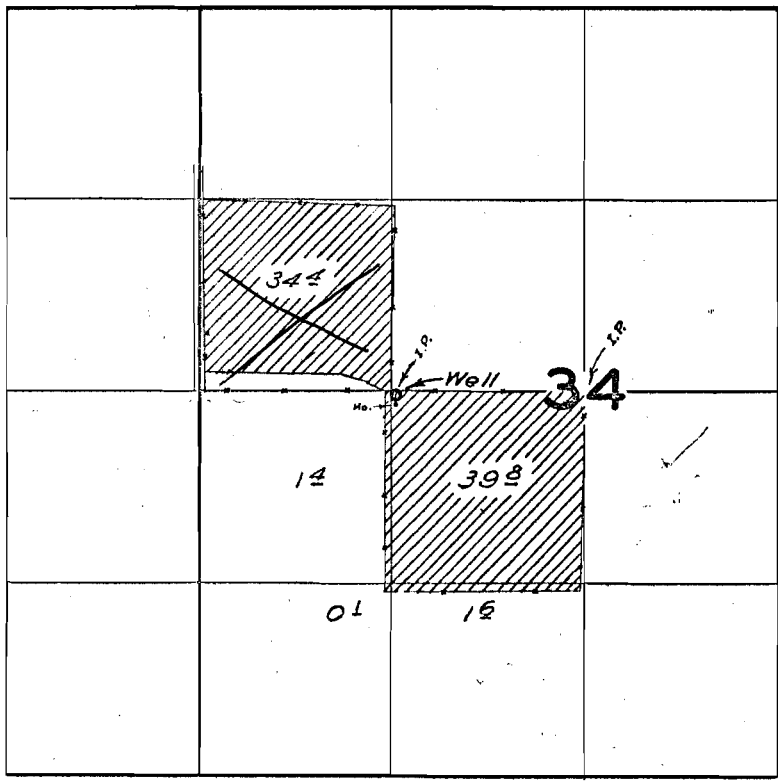

FINAL PROOF SURVEY
UNDER

Application No. U-735 Permit No. U-648
IN NAME OF

GEORGE E. MALLETT

Surveyed 11 May 1959, by M. Bish