



# T.27S.,R.16E.,W.M.

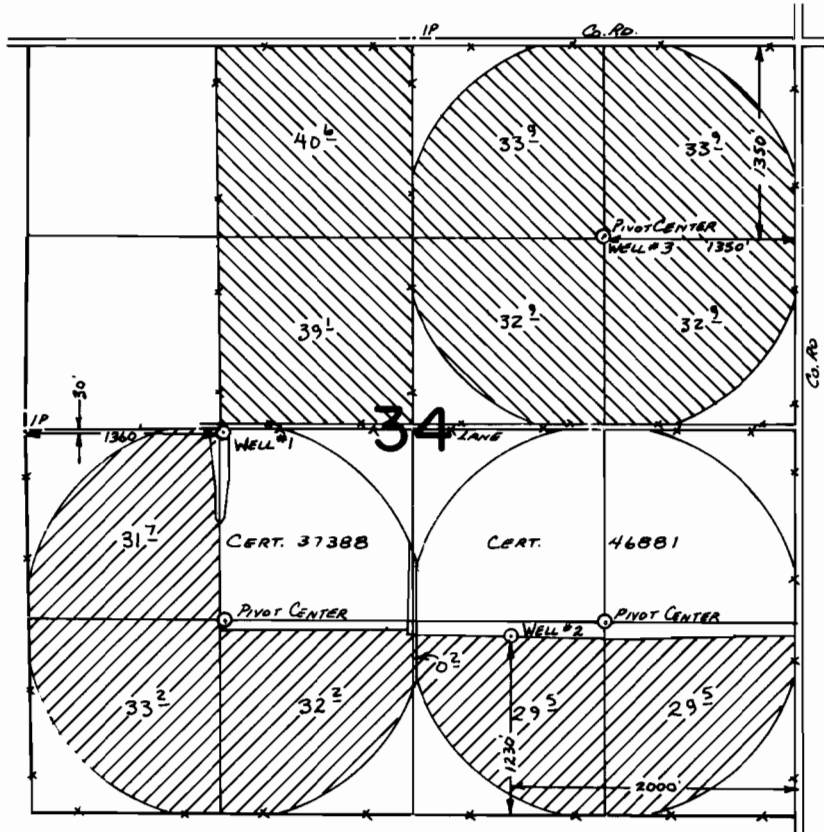

## FINAL PROOF SURVEY UNDER

Application No. ~~G-7712~~ ~~G-8813~~ Permit No. ~~G-7364~~ ~~G-8201~~   
IN NAME OF

MEARL W. & PATTY L. BLEVINS

Surveyed Oct. 14, 1983, by L. M. TOLL