


# T.6S.R.2W.W.M.

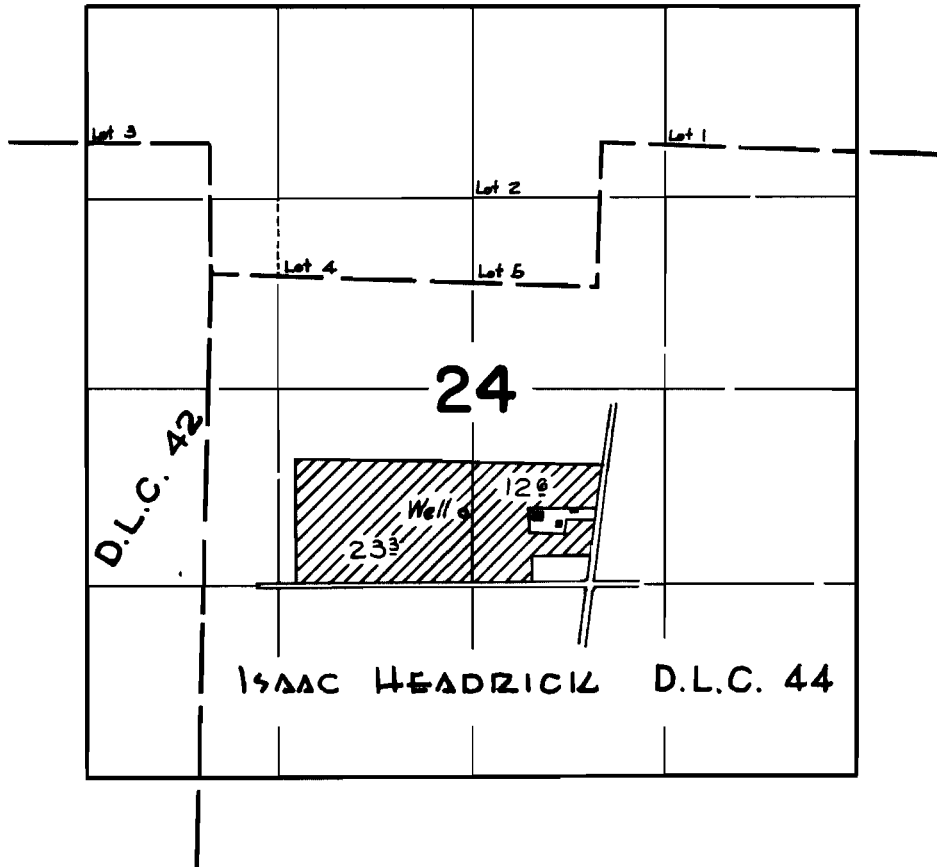

## FINAL PROOF SURVEY UNDER

Application No. G-1713 Permit No. G-1572  
IN NAME OF

WILLIAM F. LEADER

Surveyed April 26 1963, by T. LAUER

*RL*